


## Legend

- Soil Sample
- ▲ Background Soil Sample
- M Meter House
- ▶ Former Drain Line
- - - Former Drip Containment
- - -▶ Former Gas Line
- ▶ Former Oil Dump
- - -▶ Former Water Dump
- X - - Former Fence
- Former Metal Berm
- Former Infrastructure
- - - Excavation Extent

County Road 19.5

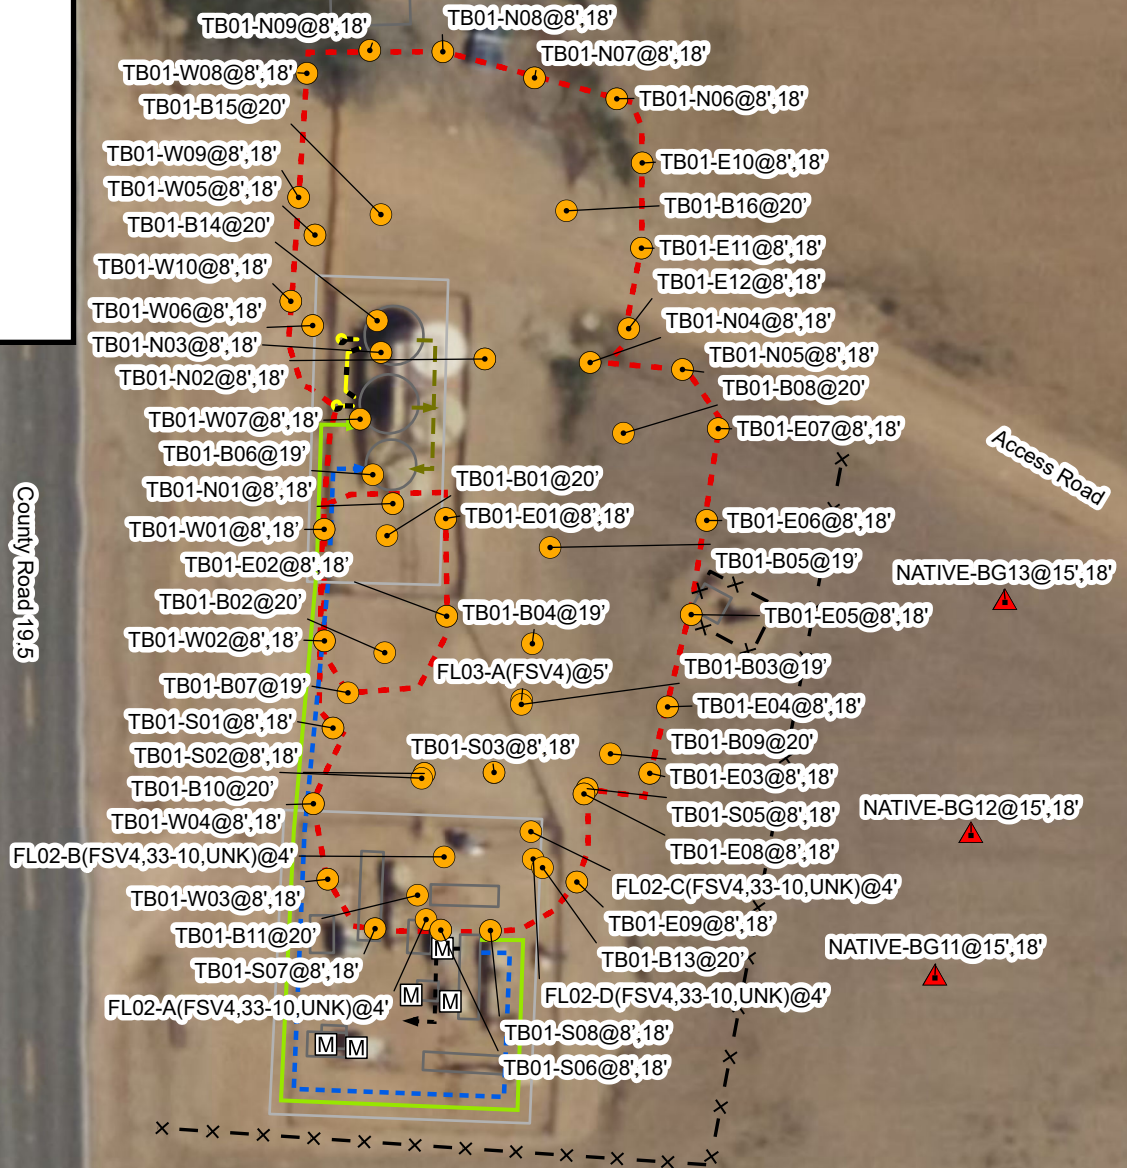

0 40 80 Feet

Sources: Environmental Systems Research Institute (ESRI)



## Excavation Site Map (06/05/2024-08/01/2024)

PSC 15-10/FSV24A&4 O SA Facility  
Kerr-McGee Oil and Gas Onshore, LP  
NWSE SEC 10-T3N-R67W  
Weld County, Colorado

Project Number: 09A1417392

FIGURE  
1B