


Site Information	
Site Name	Xeri-McGee 23-10
Date	10/2/2024
Sampler	Pendin Carcas
Weather	93° Sunny

Gas Meter Information	
Make/Model	QEM 5000
S/N	9505254

Calibration Information	
Gas	Time
Pure N ₂	1217
Fresh Air	1214
50 ppm CO, 10 ppm H ₂ S	1221
15% CH ₄ , 15% CO ₂ , Bal N ₂	1223

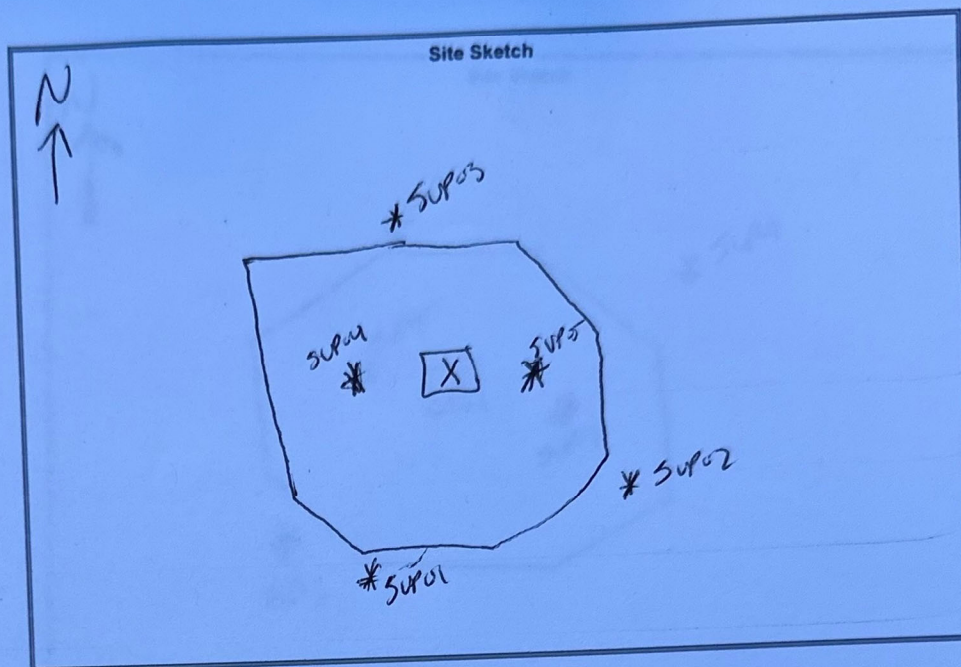

Bump Test						
Time		CH ₄ (%)	CO ₂ (%)	O ₂ (%)	H ₂ S (ppm)	CO (ppm)
1228	Calibration Gas	15.0	13.0	0.0	0	0
	Readings	14.8	14.7	0.0	0	0

[illegible]

Notes and Observations