


Legend

- P&A'd Wellhead
- Soil Sample
- Soil Screening
- Soil Vapor Point (SVP)
- Background Soil Sample
- Approximate Location of Flowline (Removed)
- Excavation Extent

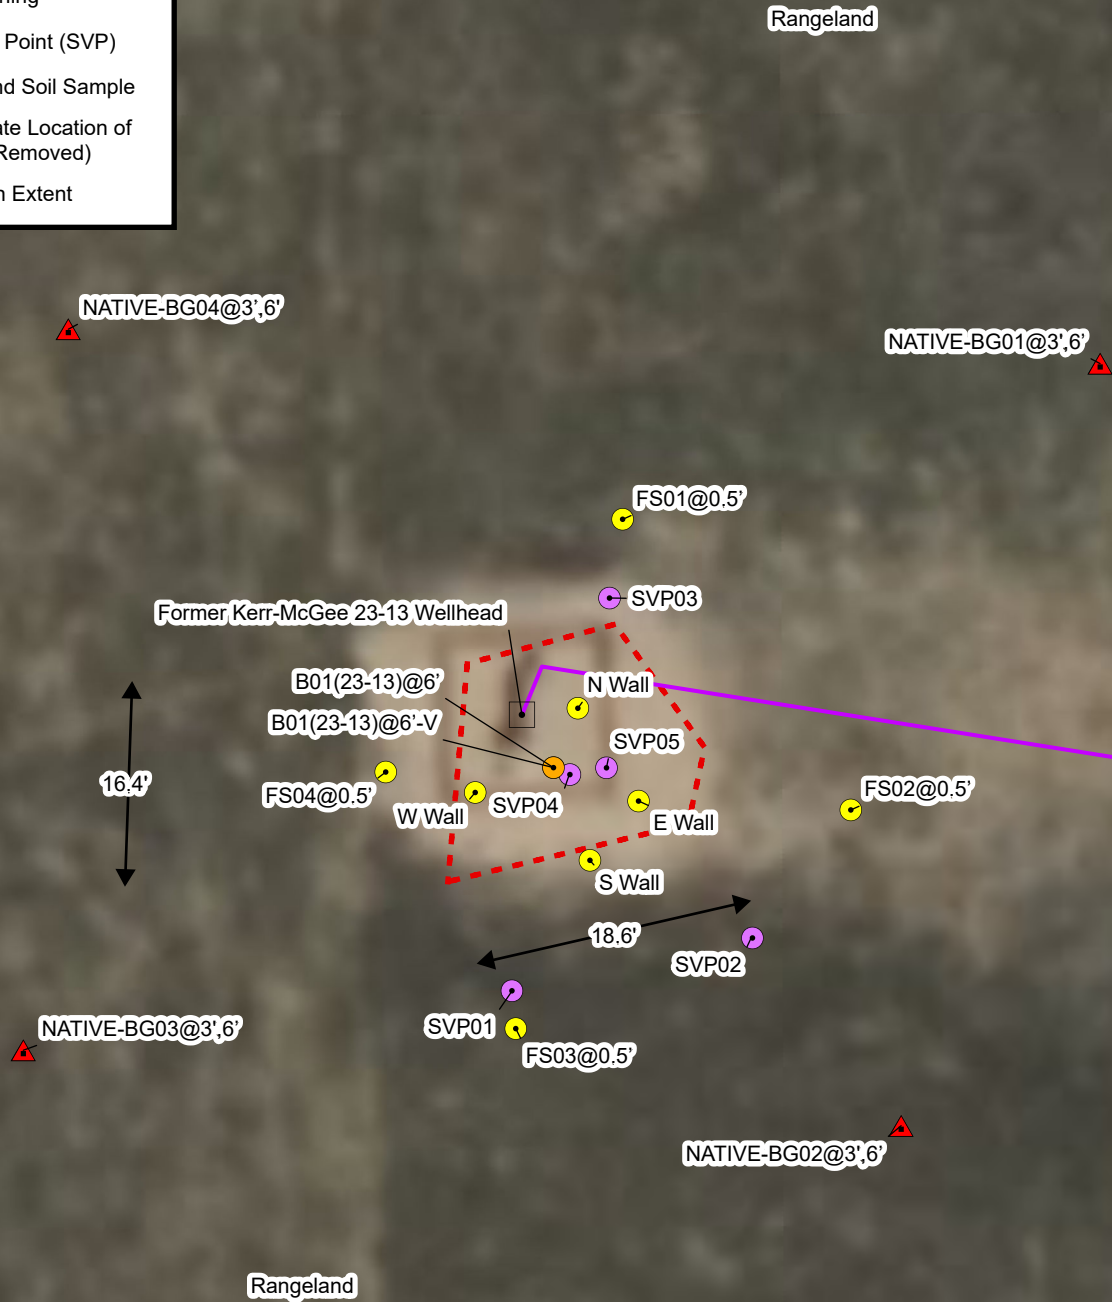

0 10 20
Feet

Sources: Environmental Systems Research Institute (ESRI)



Wellhead Excavation Site Map

Kerr-McGee 23-13 Wellhead
Kerr-McGee Oil & Gas Onshore, LP
NWSE SEC 13-T3N-R66W
Weld County, CO

Project Number: 09A1417861

FIGURE
1