


USGS 7.5 MINUTE SERIES (TOPOGRAPHIC)

Figure 1
SITE LOCATION MAP

NOBLE ENERGY INC - PATRIOT B16-24
 SESW Sec. 16, T5N, R64W, 6th PM
 Weld County, Colorado
 40.395440°, -104.555204°

Project # CO23-037	API # 05-123-25730	Facility #
Date 10/03/2023	Remediation # 25430	Filename 23037T



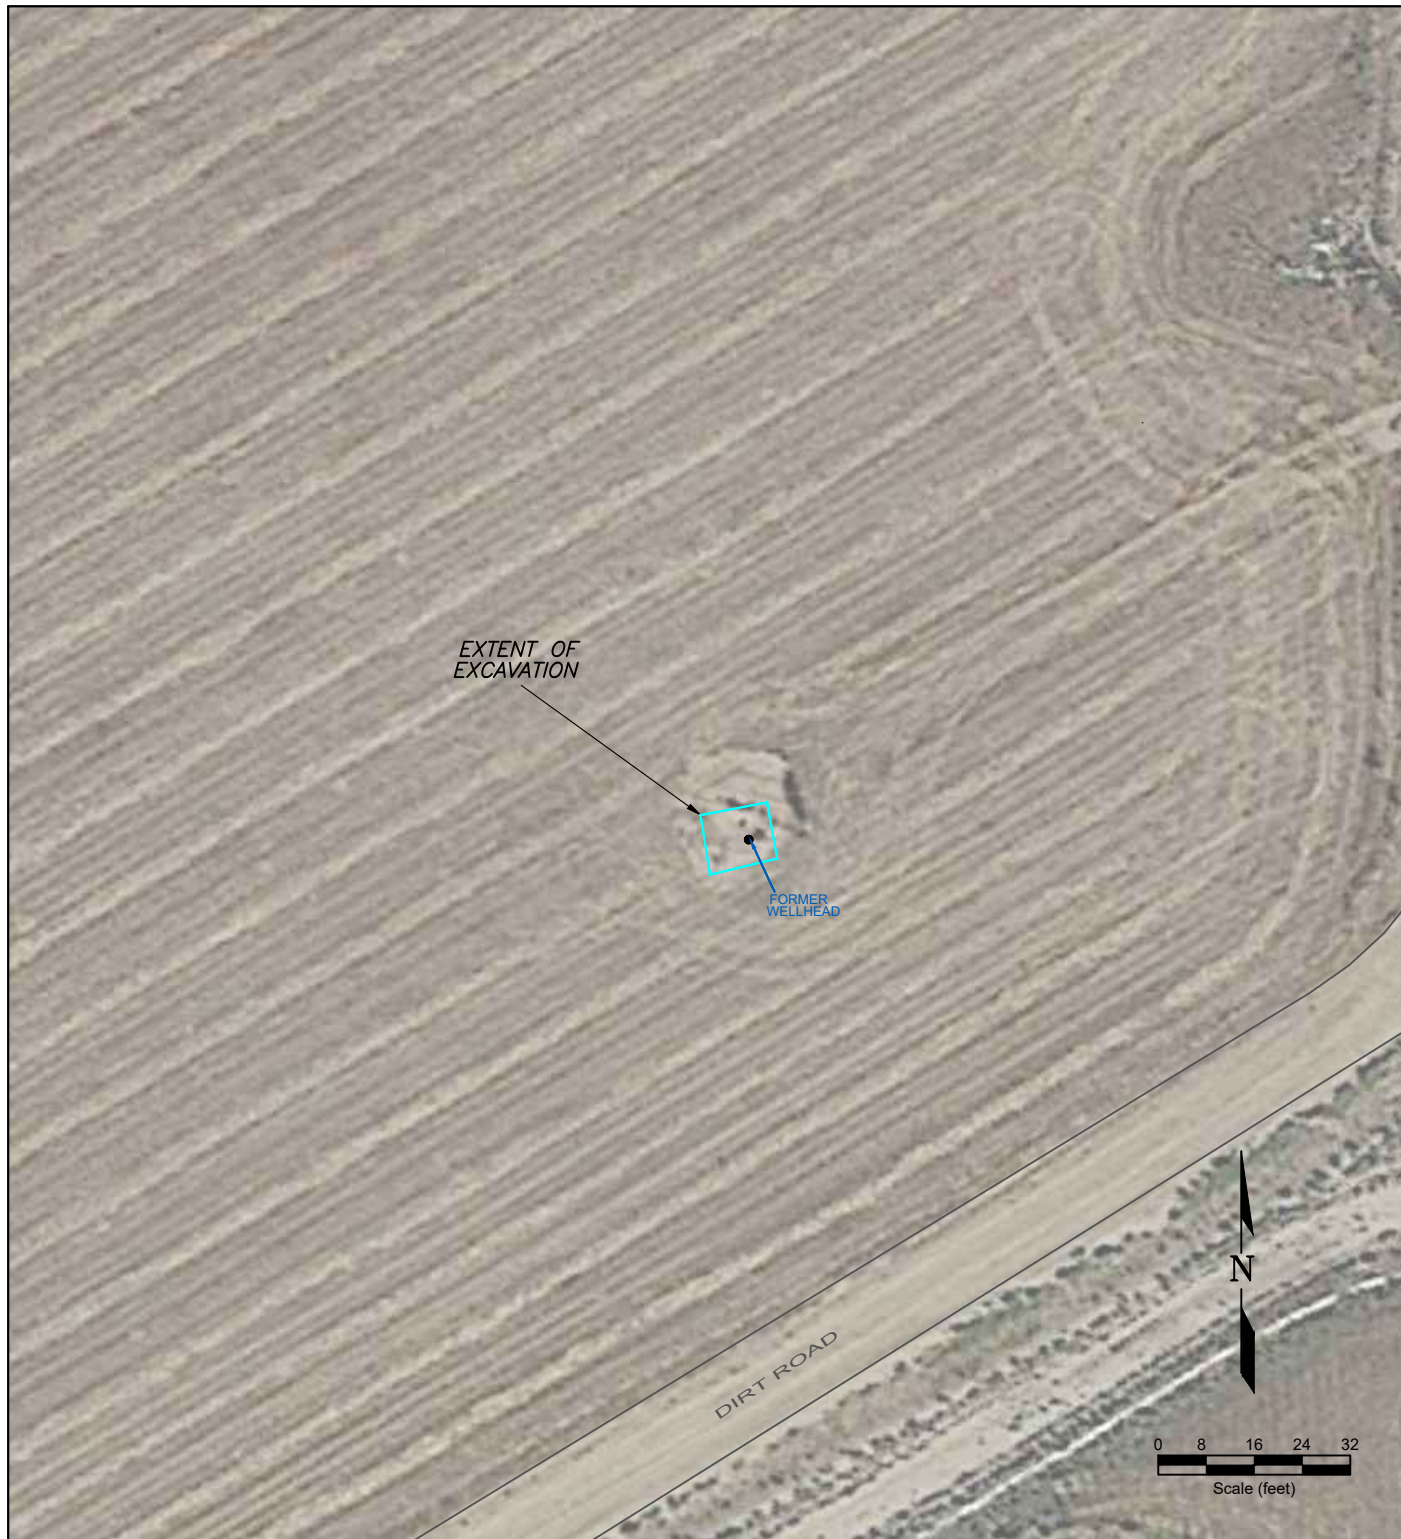

LEGEND

- WELLHEAD LOCATION
- ABOVE GROUND STORAGE TANK
- FORMER FORMER FACILITY
- FLOW LINE
- ||||| CONTAINMENT BERM
- FENCE LINE

**Figure 2
SITE MAP**

NOBLE ENERGY INC - PATRIOT B16-24
 SESW Sec. 16, T5N, R64W, 6th PM
 Weld County, Colorado
 40.395440°, -104.555204°

Project # CO23-037	API # 05-123-25730	Facility #
Date 10/03/2023	Remediation # 25430	Filename 23037Q



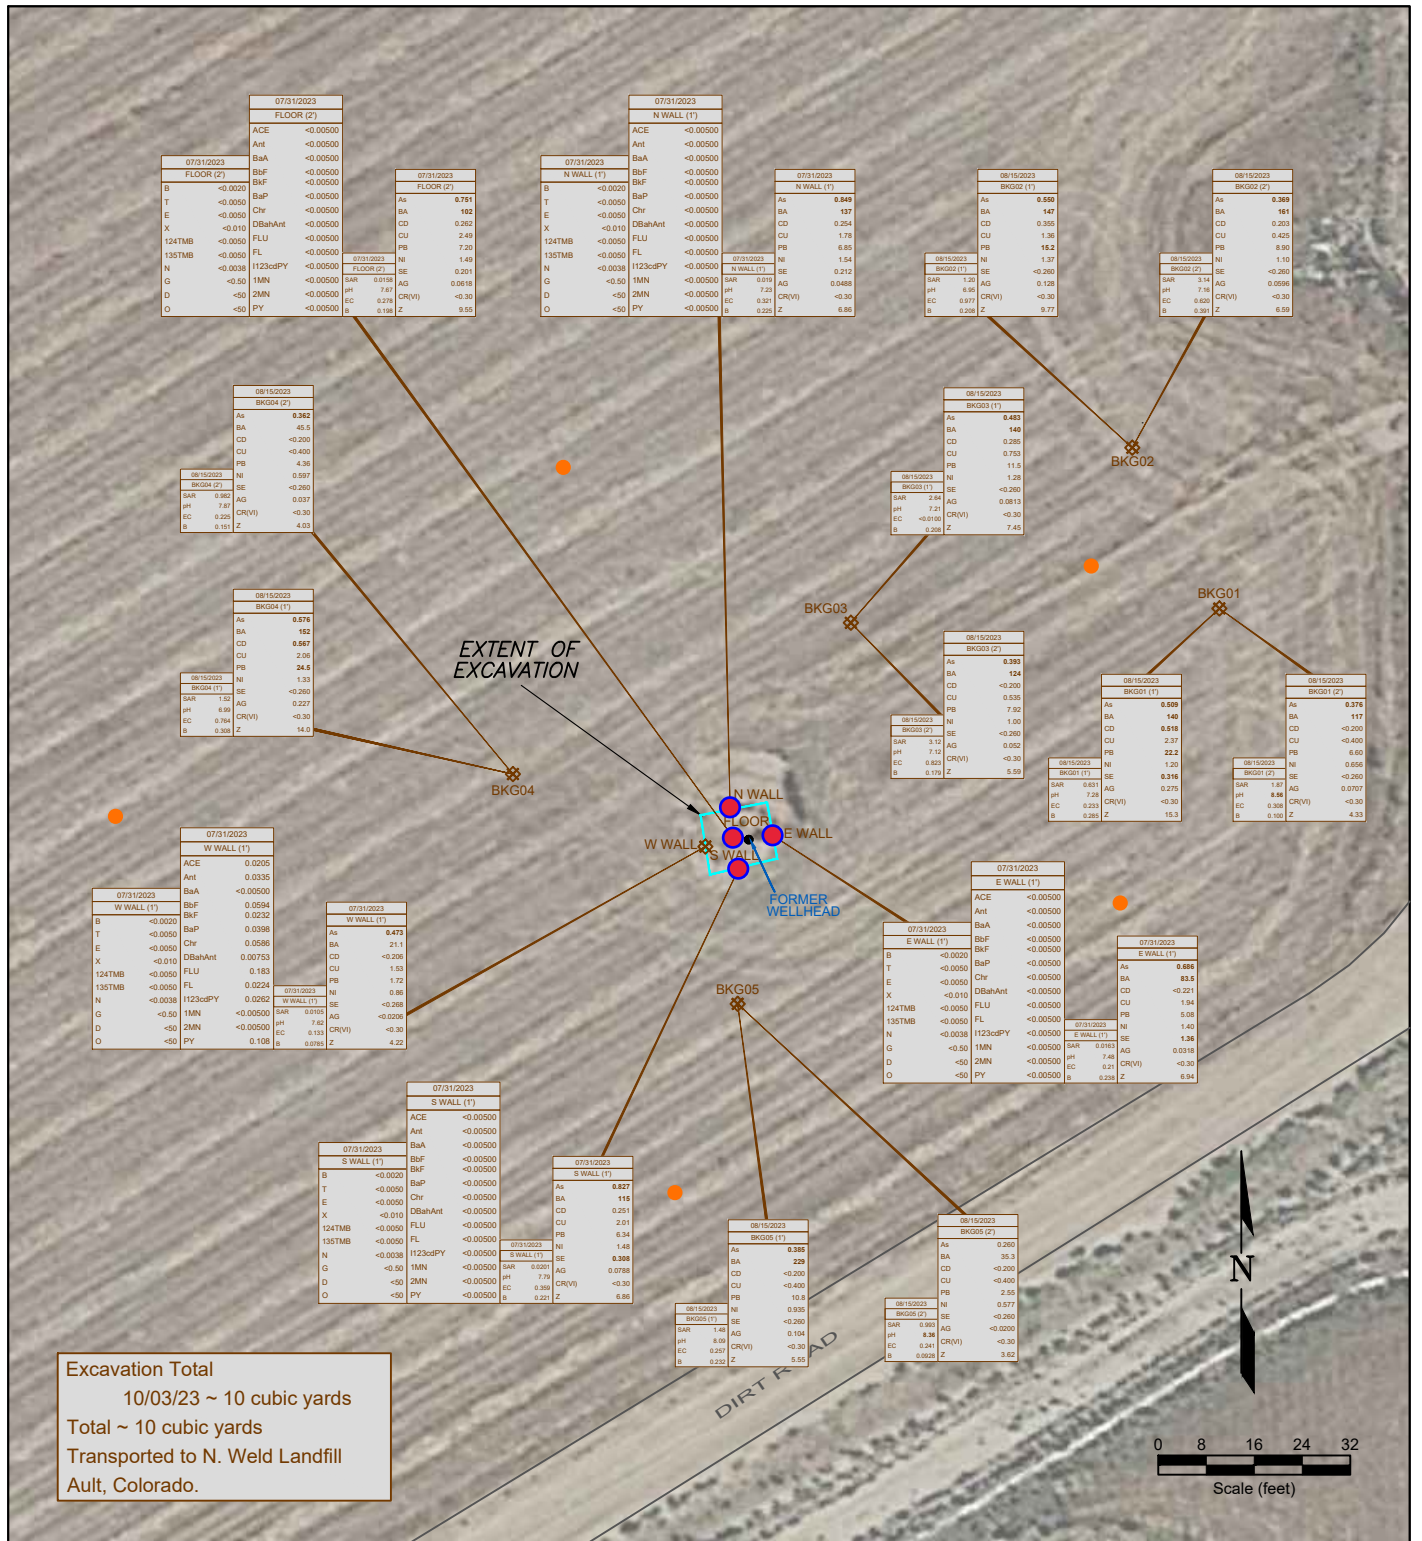


Figure 3
SOIL CHEMISTRY MAP

NOBLE ENERGY INC - PATRIOT B16-24
 SESW Sec. 16, T5N, R64W, 6th PM
 Weld County, Colorado
 40.395440°, -104.555204°

Project #	API #	Facility #
CO23-037	05-123-25730	
Date	Remediation #	Filename
10/03/2023	25430	23037Q



