

Hart-Memco 122 WH 5/21/2024
 5/21/2024 (make model) GEN 5000
 Linda Corras G1502554
 67° Sunny

Calibration info

Time	
1204	Pure N2
1202	Fresh Air
1205	50 ppm CO, 10 ppm H2S
1207	15% CH4, 15% CO2 Bal N2

Bump Test

Time		CH4 %	CO2 %	CO %	H2S	CO
1209	Calibration Gas	15.0	15.0	0.0	0	0
	Readings	14.9	15.0	0.1	0	0

	Time	CH4	CO2	CO	H2S	CO	Purge
SUP01	1213	0.0	0.4	20.6	1	0	68
SUP02	1215	0.0	1.0	19.0	1	0	61
SUP03	1217	0.0	1.3	18.7	0	0	61
SUP04							Blocked
SUP05							Blocked

Comments


SUP04 + SUP05 no longer tip fixed & blocked

Sketch



SUP03

SUP02

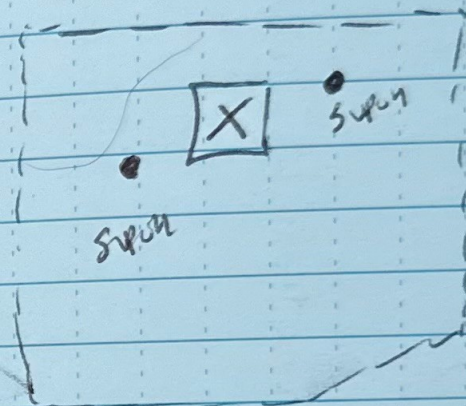

SUP01