


## Legend

- P&A'd Wellhead
- Soil Sample
- Soil Screening
- Soil Vapor Point (SVP)
- Background Soil Sample
- Approximate Location of Flowline (Removed)
- Excavation Extent

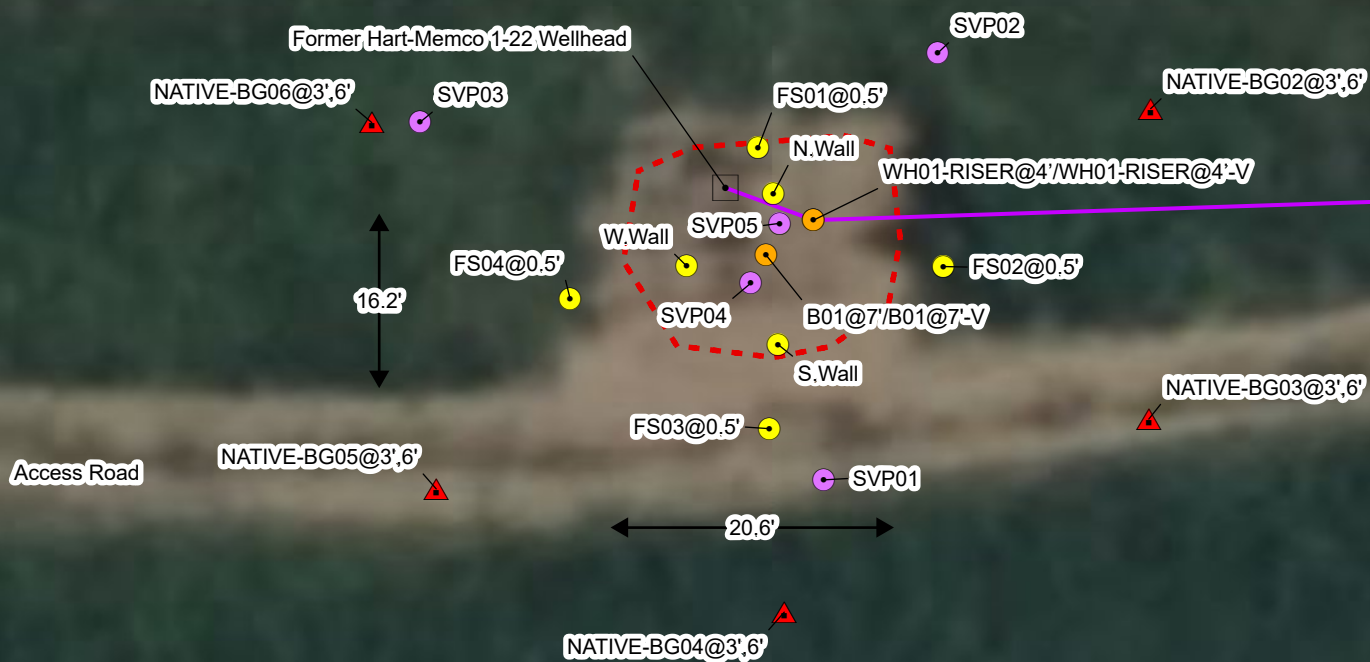

0 10 20  
Feet

Sources: Environmental Systems Research Institute (ESRI)

## Wellhead Excavation Site Map

Hart-Memco 1-22 Wellhead  
Kerr-McGee Oil and Gas Onshore, LP  
NENE SEC 22-T4N-R68W  
Weld County, Colorado

Project Number: 09A1417672

FIGURE

1

