

Attachment A

Soil Documents

TABLE 1
SOIL SAMPLE LOCATIONS
NOBLE ENERGY, INC. - THOMPSON 28-10 FAC

Soil Sample ID	Date	PID (ppm)	Visual	Olfactory	Sample Type (Grab/Lab)	Latitude ¹	Longitude	PDOP
SEP01-FL@3.5'	02/27/23	0.2	No Staining	No Odor	Lab	40.2808032	-104.5593418	1.9
SEP01-DL@4'	02/27/23	0.2	No Staining	No Odor	Lab	40.2807648	-104.5593856	0.8
MH01@0.5'	02/27/23	0.6	No Staining	No Odor	Grab	40.2807335	-104.5592862	1.1
MH02@0.5'	02/27/23	0.3	No Staining	No Odor	Grab	40.2807676	-104.5593304	0.9
Flare01@0.5'	02/27/23	0.3	No Staining	No Odor	Grab	40.2807066	-104.5592242	0.9
AST01@0.5'	02/27/23	0.0	No Staining	No Odor	Lab	40.2806712	-104.5596889	2.1
SS01@2.5'	03/02/23	0.4	No Staining	No Odor	Lab	40.2807278	-104.5596322	0.9
SS02@2.5'	03/02/23	1.0	No Staining	No Odor	Lab	40.2807086	-104.5595922	0.9
SS03@2.5'	03/02/23	0.6	No Staining	No Odor	Lab	40.2806886	-104.5596275	0.8
SS04@2.5'	03/02/23	1.0	No Staining	No Odor	Lab	40.2807078	-104.5596582	0.8
FS01@5.5'	03/02/23	0.7	No Staining	No Odor	Lab	40.2807078	-104.5596302	1.1
BH01*	06/02/24	2.5	No Staining	No Odor	Lab	40.2807175	-104.5596323	1.9
BH02*	06/02/24	2.4	No Staining	No Odor	Lab	40.2807842	-104.5596414	1.9
BH03*	06/02/24	3.1	No Staining	No Odor	Lab	40.2807149	-104.5595592	1.9
BH04*	06/02/24	3.4	No Staining	No Odor	Lab	40.2806507	-104.5596299	1.9
BH05*	06/02/24	3.9	No Staining	No Odor	Lab	40.2807138	-104.5597225	1.9
BH06*	06/02/24	1.0	No Staining	No Odor	Lab	40.2806506	-104.5597234	1.9
BG01*	06/02/24	NC	No Staining	No Odor	Lab	40.2805521	-104.5598508	NC
BG02*	06/02/24	NC	No Staining	No Odor	Lab	40.2806961	-104.5598749	NC
BG03*	06/02/24	NC	No Staining	No Odor	Lab	40.2808414	-104.5597390	NC
BG04*	06/02/24	NC	No Staining	No Odor	Lab	40.2808708	-104.5593956	NC
BG05*	06/02/24	NC	No Staining	No Odor	Lab	40.2808164	-104.5591382	NC

Notes:

PID = Photo-ionization detector

ppm = parts per million

PDOP = Position dilution of precision

HC = Hydrocarbon

1.) Latitude and longitude coordinates will be provided in decimal degrees with an accuracy and precision of 5 decimals of a degree using the North American Datum ("NAD") of 1983

* PID readings represent the maximum PID reading recorded for the borehole location.


NC = Data not collected

TABLE 2
SOIL ANALYTICAL DATA
NOBLE ENERGY, INC. - THOMPSON 28-10 FACILITY

Soil Sample ID	Date	¹ Benzene (mg/kg)	Toluene (mg/kg)	Ethylbenzene (mg/kg)	Total Xylenes (mg/kg)	1,2,4 - TMB (mg/kg)	1,3,5 - TMB (mg/kg)	Naphthalene (mg/kg)	TPH-GRO (mg/kg)	TPH-DRO (mg/kg)	TPH-ORO (mg/kg)	Acenaphthene (mg/kg)	Anthracene (mg/kg)	Benz(a) (mg/kg)	Benzo(a) (mg/kg)	Benzo(b) (mg/kg)	Benzo(k) (mg/kg)	Chrysene (mg/kg)	A,H (mg/kg)	Fluoranthene (mg/kg)	Fluorene (mg/kg)	1,2,3-CD (mg/kg)	Pyrene (mg/kg)	1-M (mg/kg)	2-M (mg/kg)
Residential SSL ²		1.2	490	5.8	58	30	27	2	500			360	1,800	1.1	0.11	1.1	11	110	0.11	240	240	1.1	180	18	24
Protection of Groundwater SSL ^{2,3}		0.0026	0.69	0.78	9.9	0.0081	0.0087	0.0038	500			0.55	6	0.011	0.24	0.3	2.9	9	0.096	8.9	0.54	0.98	1.3	0.006	0.019
SEP01-FL@3.5'	02/27/23	<0.0020	<0.0050	<0.0050	<0.010	<0.0050	<0.0050	<0.0038	<0.50	<50	<50	<0.00500	<0.00500	<0.00500	<0.00500	<0.00500	<0.00500	<0.00500	<0.00500	<0.00500	<0.00500	<0.00500	<0.00500	<0.00500	<0.00500
SEP01-DL@4'	02/27/23	<0.0020	<0.0050	<0.0050	<0.010	<0.0050	<0.0050	<0.0038	<0.50	<50	<50	<0.00500	<0.00500	<0.00500	<0.00500	<0.00500	<0.00500	<0.00500	<0.00500	<0.00500	<0.00500	<0.00500	<0.00500	<0.00500	<0.00500
AST01@0.5'	02/27/23	<0.0020	<0.0050	<0.0050	<0.010	<0.0050	<0.0050	<0.0038	<0.50	<50	<50	<0.00500	<0.00500	<0.00500	<0.00500	<0.00500	<0.00500	<0.00500	<0.00500	<0.00500	<0.00500	<0.00500	<0.00500	<0.00500	<0.00500
SS01@2.5'	03/02/23	<0.0020	<0.0050	<0.0050	<0.010	<0.0050	<0.0050	<0.0038	<0.50	<50	<50	<0.00500	<0.00500	<0.00500	<0.00500	<0.00500	<0.00500	<0.00500	<0.00500	<0.00500	<0.00500	<0.00500	<0.00500	<0.00500	<0.00500
SS02@2.5'	03/02/23	<0.0020	<0.0050	<0.0050	<0.010	<0.0050	<0.0050	<0.0038	<0.50	<50	<50	<0.00500	<0.00500	<0.00500	<0.00500	<0.00500	<0.00500	<0.00500	<0.00500	<0.00500	<0.00500	<0.00500	<0.00500	<0.00500	<0.00500
SS03@2.5'	03/02/23	<0.0020	<0.0050	<0.0050	<0.010	<0.0050	<0.0050	<0.0038	<0.50	<50	<50	<0.00500	<0.00500	<0.00500	<0.00500	<0.00500	<0.00500	<0.00500	<0.00500	<0.00500	<0.00500	<0.00500	<0.00500	<0.00500	<0.00500
SS04@2.5'	03/02/23	<0.0020	<0.0050	<0.0050	<0.010	<0.0050	<0.0050	<0.0038	<0.50	<50	<50	<0.00500	<0.00500	<0.00500	<0.00500	<0.00500	<0.00500	<0.00500	<0.00500	<0.00500	<0.00500	<0.00500	<0.00500	<0.00500	<0.00500
FS01@5.5'	03/02/23	<0.0020	<0.0050	<0.0050	<0.010	0.067	0.035	<0.0038	1.9	<50	<50	<0.00500	<0.00500	<0.00500	<0.00500	<0.00500	<0.00500	<0.00500	<0.00500	<0.00500	<0.00500	<0.00500	<0.00500	0.00510	0.0192
BH01@6'	06/02/23	<0.0020	<0.0050	<0.0050	<0.010	<0.0050	<0.0050	<0.0038	<0.50	<50	<50	<0.00500	<0.00500	<0.00500	<0.00500	<0.00500	<0.00500	<0.00500	<0.00500	<0.00500	<0.00500	<0.00500	<0.00500	<0.00500	<0.00500
BH01@18-19'	06/02/23	<0.0020	<0.0050	<0.0050	<0.010	<0.0050	<0.0050	<0.0038	<0.50	<50	<50	<0.00500	<0.00500	<0.00500	<0.00500	<0.00500	<0.00500	<0.00500	<0.00500	<0.00500	<0.00500	<0.00500	<0.00500	<0.00500	<0.00500
BH02@6'	06/02/23	<0.0020	<0.0050	<0.0050	<0.010	<0.0050	<0.0050	<0.0038	<0.50	<50	<50	<0.00500	<0.00500	<0.00500	<0.00500	<0.00500	<0.00500	<0.00500	<0.00500	<0.00500	<0.00500	<0.00500	<0.00500	<0.00500	<0.00500
BH02@18-19'	06/02/23	<0.0020	<0.0050	<0.0050	<0.010	<0.0050	<0.0050	<0.0038	<0.50	<50	<50	<0.00500	<0.00500	<0.00500	<0.00500	<0.00500	<0.00500	<0.00500	<0.00500	<0.00500	<0.00500	<0.00500	<0.00500	<0.00500	<0.00500
BH03@6'	06/02/23	<0.0020	<0.0050	<0.0050	<0.010	<0.0050	<0.0050	<0.0038	<0.50	<50	<50	<0.00500	<0.00500	<0.00500	<0.00500	<0.00500	<0.00500	<0.00500	<0.00500	<0.00500	<0.00500	<0.00500	<0.00500	<0.00500	<0.00500
BH03@18-19'	06/02/23	<0.0020	<0.0050	<0.0050	<0.010	<0.0050	<0.0050	<0.0038	<0.50	<50	<50	<0.00500	<0.00500	<0.00500	<0.00500	<0.00500	<0.00500	<0.00500	<0.00500	<0.00500	<0.00500	<0.00500	<0.00500	<0.00500	<0.00500
BH04@6'	06/02/23	<0.0020	<0.0050	<0.0050	<0.010	<0.0050	<0.0050	<0.0038	<0.50	<50	<50	<0.00500	<0.00500	<0.00500	<0.00500	<0.00500	<0.00500	<0.00500	<0.00500	<0.00500	<0.00500	<0.00500	<0.00500	<0.00500	<0.00500
BH04@18-19'	06/02/23	<0.0020	<0.0050	<0.0050	<0.010	<0.0050	<0.0050	<0.0038	<0.50	<50	<50	<0.00500	<0.00500	<0.00500	<0.00500	<0.00500	<0.00500	<0.00500	<0.00500	<0.00500	<0.00500	<0.00500	<0.00500	<0.00500	<0.00500
BH05@6'	06/02/23	<0.0020	<0.0050	<0.0050	<0.010	<0.0050	<0.0050	<0.0038	<0.50	<50	<50	<0.00500	<0.00500	<0.00500	<0.00500	<0.00500	<0.00500	<0.00500	<0.00500	<0.00500	<0.00500	<0.00500	<0.00500	<0.00500	<0.00500
BH05@18-19'	06/02/23	<0.0020	<0.0050	<0.0050	<0.010	<0.0050	<0.0050	<0.0038	<0.50	<50	<50	<0.00500	<0.00500	<0.00500	<0.00500	<0.00500	<0.00500	<0.00500	<0.00500	<0.00500	<0.00500	<0.00500	<0.00500	<0.00500	<0.00500

Soil Sample ID	Date	pH	SAR	EC (mmhos/cm)	Boron (mg/L)
Residential SSL ²		6 - 8.3	<6	<4mmhos/cm	2
SEP01-FL@3.5'	02/27/23	7.91	0.107	0.245	0.110
SEP01-DL@4'	02/27/23	7.23	0.274	0.215	0.0870
AST01@0.5'	02/27/23	4.89	0.0363	0.0665	0.0316
SS01@2.5'	03/02/23	7.90	0.0205	0.100	0.0922
SS02@2.5'	03/02/23	7.93	0.0658	0.211	0.141
SS03@2.5'	03/02/23	7.65	0.130	0.144	0.118
SS04@2.5'	03/02/23	7.64	0.0190	0.0856	0.0942
FS01@5.5'	03/02/23	7.85	0.295	0.262	0.128
BH01@0.5'	06/02/23	8.29	NA	NA	NA
BH01@6'	06/02/23	7.52	0.356	0.526	0.0486
BH01@18-19'	06/02/23	8.24	1.67	0.301	0.258
BH02@0.5'	06/02/23	7.94	NA	NA	NA
BH02@6'	06/02/23	7.42	0.0660	0.203	0.0798
BH02@18-19'	06/02/23	7.89	2.73	0.438	0.140
BH03@0.5'	06/02/23	8.03	NA	NA	NA
BH03@6'	06/02/23	7.72	1.36	0.352	0.0648
BH03@18-19'	06/02/23	7.85	1.99	0.356	0.317
BH04@0.5'	06/02/23	7.93	NA	NA	NA
BH04@6'	06/02/23	7.12	0.145	0.315	0.0555
BH04@18-19'	06/02/23	7.92	2.15	0.406	0.171
BH05@0.5'	06/02/23	7.83	NA	NA	NA
BH05@6'	06/02/23	7.71	1.57	0.495	0.0788
BH05@18-19'	06/02/23	8.04	2.44	0.305	0.206
BH06@0.5'	06/02/23	7.61	NA	NA	NA
BG01@0.5'	06/02/23	6.41	NA	NA	NA
BG01@6'	06/02/23	7.80	NA	NA	NA
BG01@18-19'	06/02/23	8.13	NA	NA	NA
BG02@0.5'	06/02/23	8.10	NA	NA	NA
BG02@6'	06/02/23	7.85	NA	NA	NA
BG02@18-19'	06/02/23	8.20	NA	NA	NA
BG03@0.5'	06/02/23	8.14	NA	NA	NA
BG03@6'	06/02/23	8.22	NA	NA	NA
BG03@18-19'	06/02/23	8.19	NA	NA	NA
BG04@0.5'	06/02/23	7.92	NA	NA	NA
BG04@6'	06/02/23	8.27	NA	NA	NA
BG04@18-19'	06/02/23	8.26	NA	NA	NA
BG05@0.5'	06/02/23	6.32	NA	NA	NA
BG05@6'	06/02/23	8.28	NA	NA	NA
BG05@18-19'	06/02/23	8.22	NA	NA	NA

Soil Sample ID	Date	Arsenic (mg/kg)	Barium (mg/kg)	Cadmium (mg/kg)	Chromium (VI) (mg/kg)	Copper (mg/kg)	Lead (mg/kg)	Nickel (mg/kg)	Selenium (mg/kg)	Silver (mg/kg)	Zinc (mg/kg)
Residential SSL ²		0.68	15,000	71	0.3	3,100	400	1,500	390	390	23,000
Protection of Groundwater SSL ^{2,3}		0.29	82	0.38	0.00067	46	14	26	0.26	0.8	370
FS01@5.5'	03/02/23	1.54	34.2	<0.213	<0.30	2.92	3.02	2.39	<0.260	<0.0213	9.50
BH01@6'	06/02/23	1.44	NA	NA	NA	NA	NA	NA	NA	NA	NA
BH01@18-19'	06/02/23	2.59	NA	NA	NA	NA	NA	NA	NA	NA	NA
BH02@6'	06/02/23	1.25	NA	NA	NA	NA	NA	NA	NA	NA	NA
BH02@18-19'	06/02/23	1.61	NA	NA	NA	NA	NA	NA	NA	NA	NA
BH03@6'	06/02/23	2.01	NA	NA	NA	NA	NA	NA	NA	NA	NA
BH03@18-19'	06/02/23	3.57	NA	NA	NA	NA	NA	NA	NA	NA	NA
BH04@6'	06/02/23	1.48	NA	NA	NA	NA	NA	NA	NA	NA	NA
BH04@18-19'	06/02/23	3.54	NA	NA	NA	NA	NA	NA	NA	NA	NA
BH05@6'	06/02/23	0.995	NA	NA	NA	NA	NA	NA	NA	NA	NA
BH05@18-19'	06/02/23	2.31	NA	NA	NA	NA	NA	NA	NA	NA	NA
BG01@6'	06/02/23	1.61	NA	NA	NA	NA	NA	NA	NA	NA	NA
BG01@18-19'	06/02/23	4.00	NA	NA	NA	NA	NA	NA	NA	NA	NA
BG02@6'	06/02/23	1.61	NA	NA	NA	NA	NA	NA	NA	NA	NA
BG02@18-19'	06/02/23	3.39	NA	NA	NA	NA	NA	NA	NA	NA	NA
BG03@6'	06/02/23	1.79	NA	NA	NA	NA	NA	NA	NA	NA	NA
BG03@18-19'	06/02/23	1.47	NA	NA	NA	NA	NA	NA	NA	NA	NA
BG04@6'	06/02/23	0.521	NA	NA	NA	NA	NA	NA	NA	NA	NA
BG04@18-19'	06/02/23	1.27	NA	NA	NA	NA	NA	NA	NA	NA	NA
BG05@6'	06/02/23	0.540	NA	NA	NA	NA	NA	NA	NA	NA	NA
BG05@18-19'	06/02/23	1.06	NA	NA	NA	NA	NA	NA	NA	NA	NA
Highest Background @ 6'		1.79									
Highest Background @ 6' x1.25		2.24									
Highest Background @ 18-19'		4.00									
Highest Background @ 18-19' x1.25		5.00									

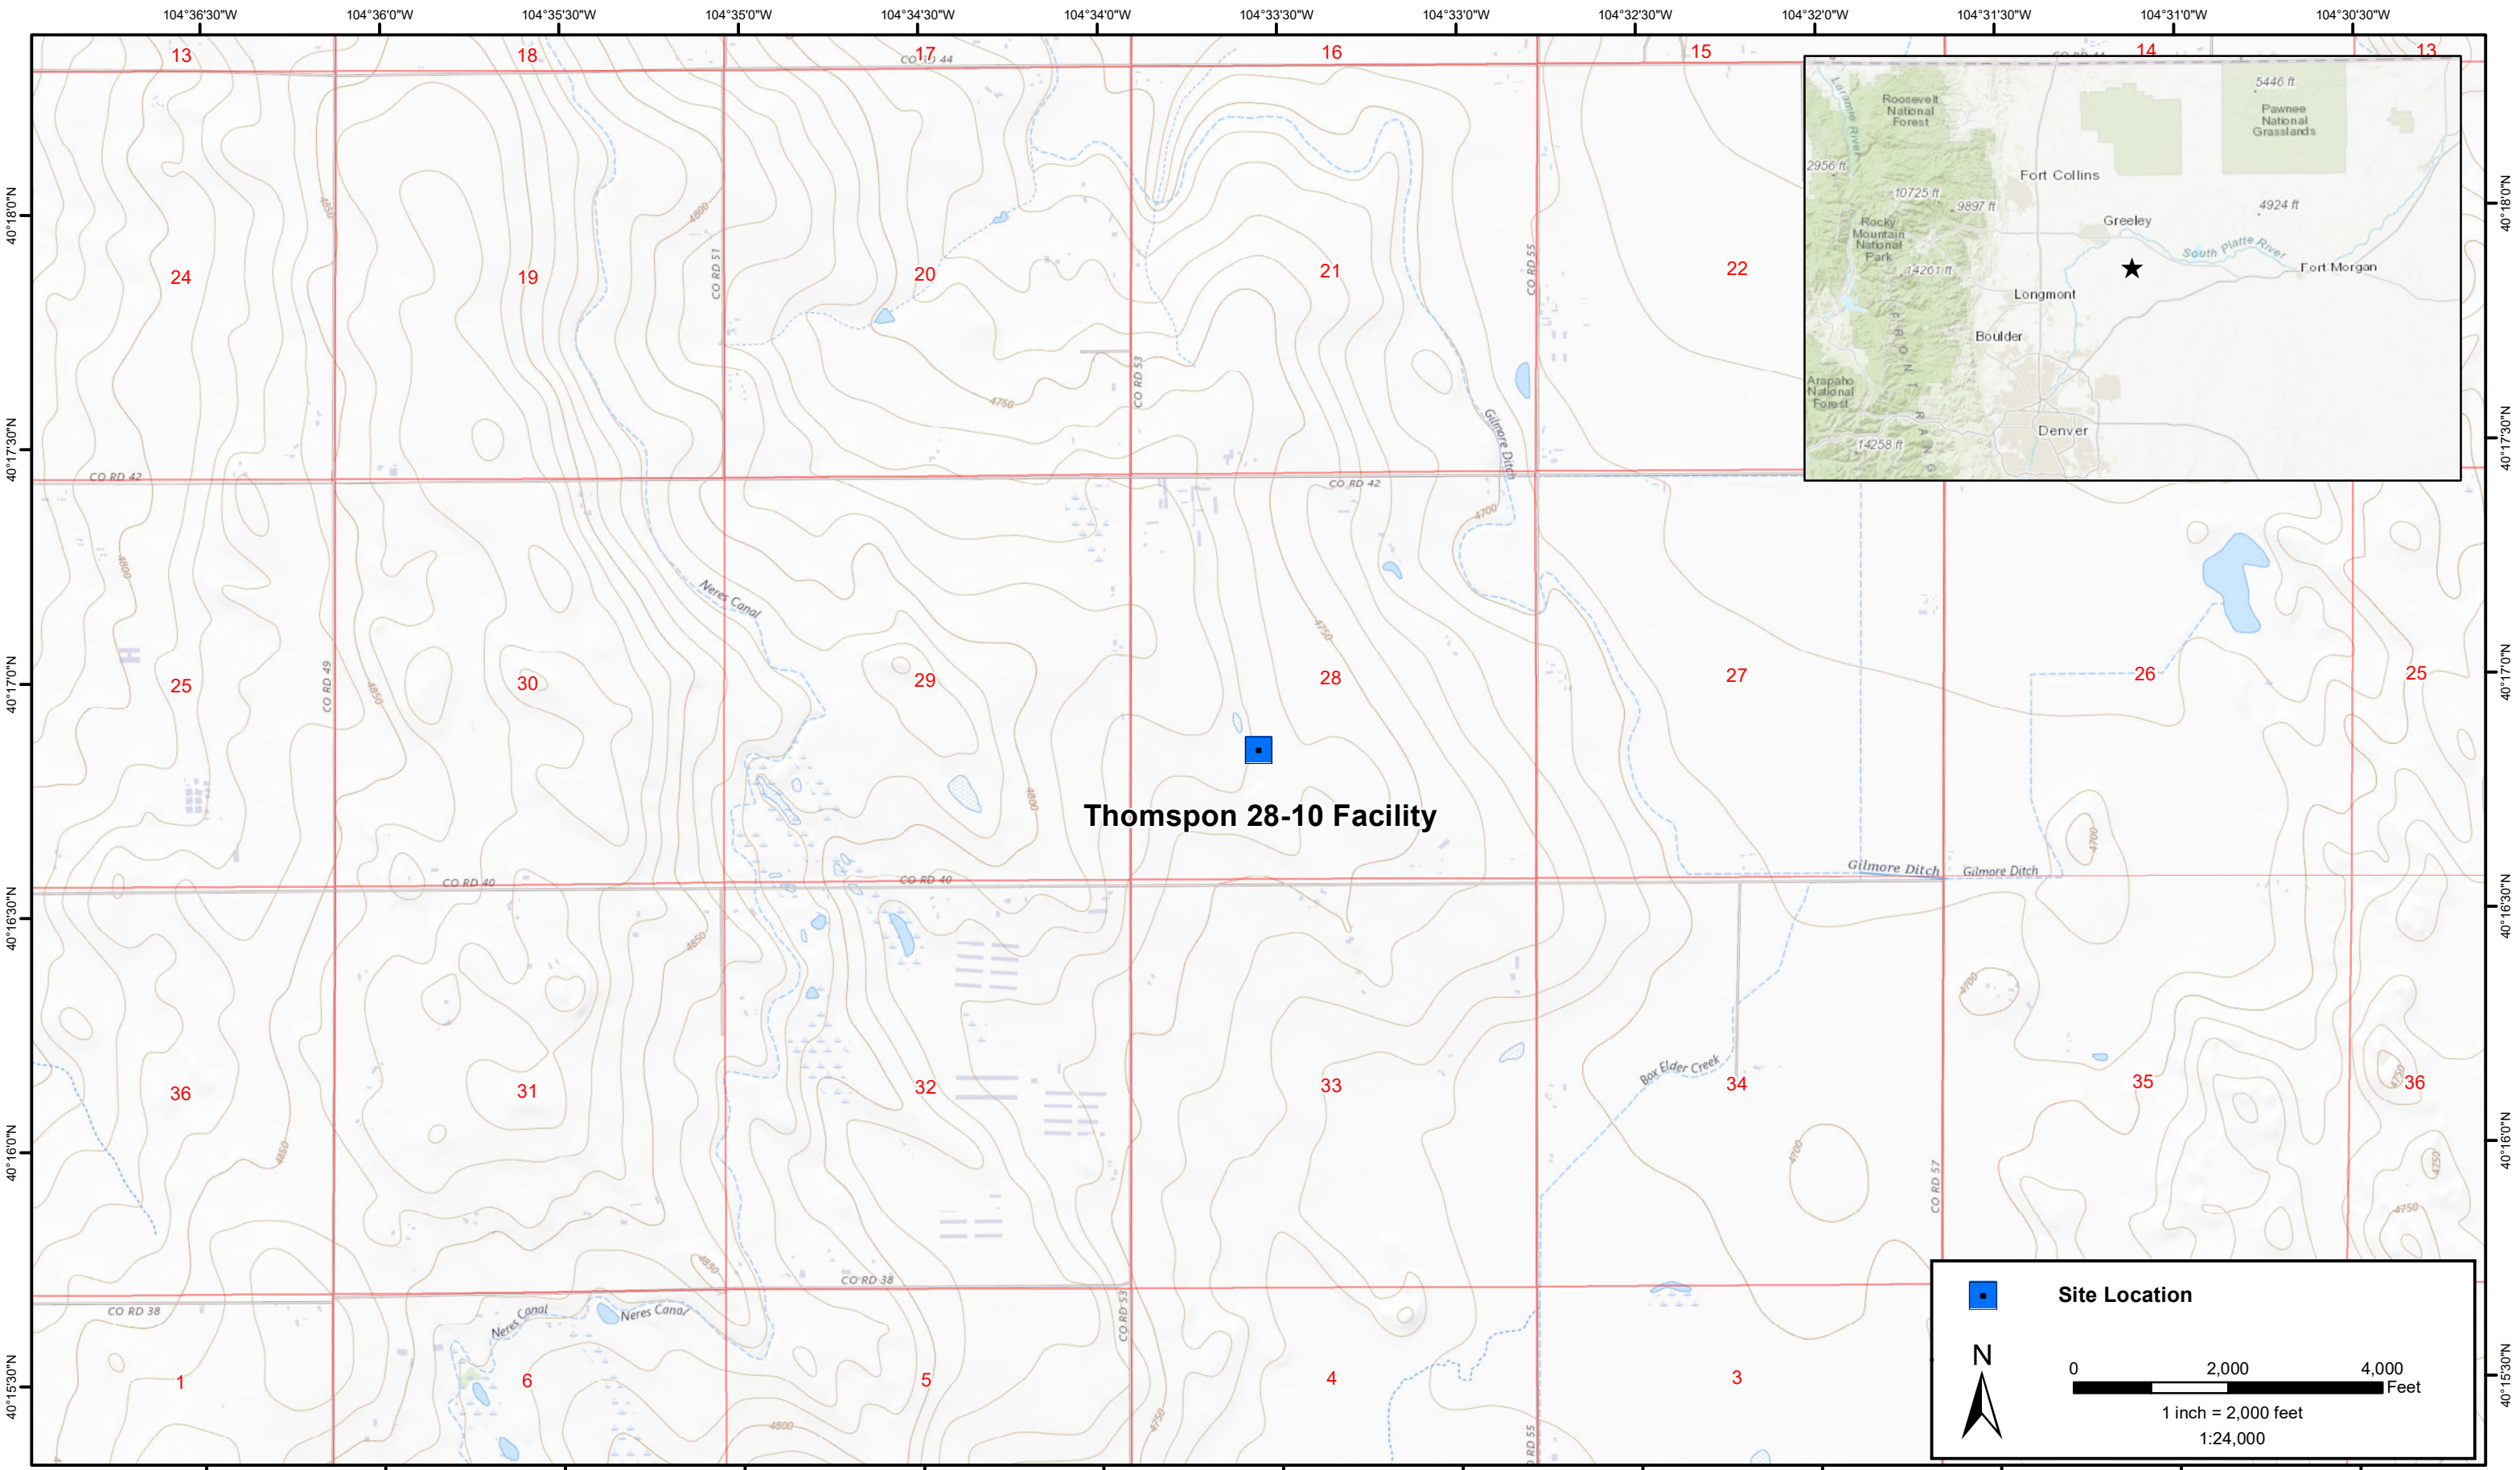

DATE:	March 2023
DESIGNED BY:	S. Vogt
DRAWN BY:	L. Reed




Tasman, Inc.
6855 W. 119th Ave
Broomfield, CO 80020

Noble Energy, Inc - DJ Basin
Thomspson 28-10 Facility
NESW Sec 28 T4N-R64W
Weld County, Colorado

Site Location Map

Figure
1



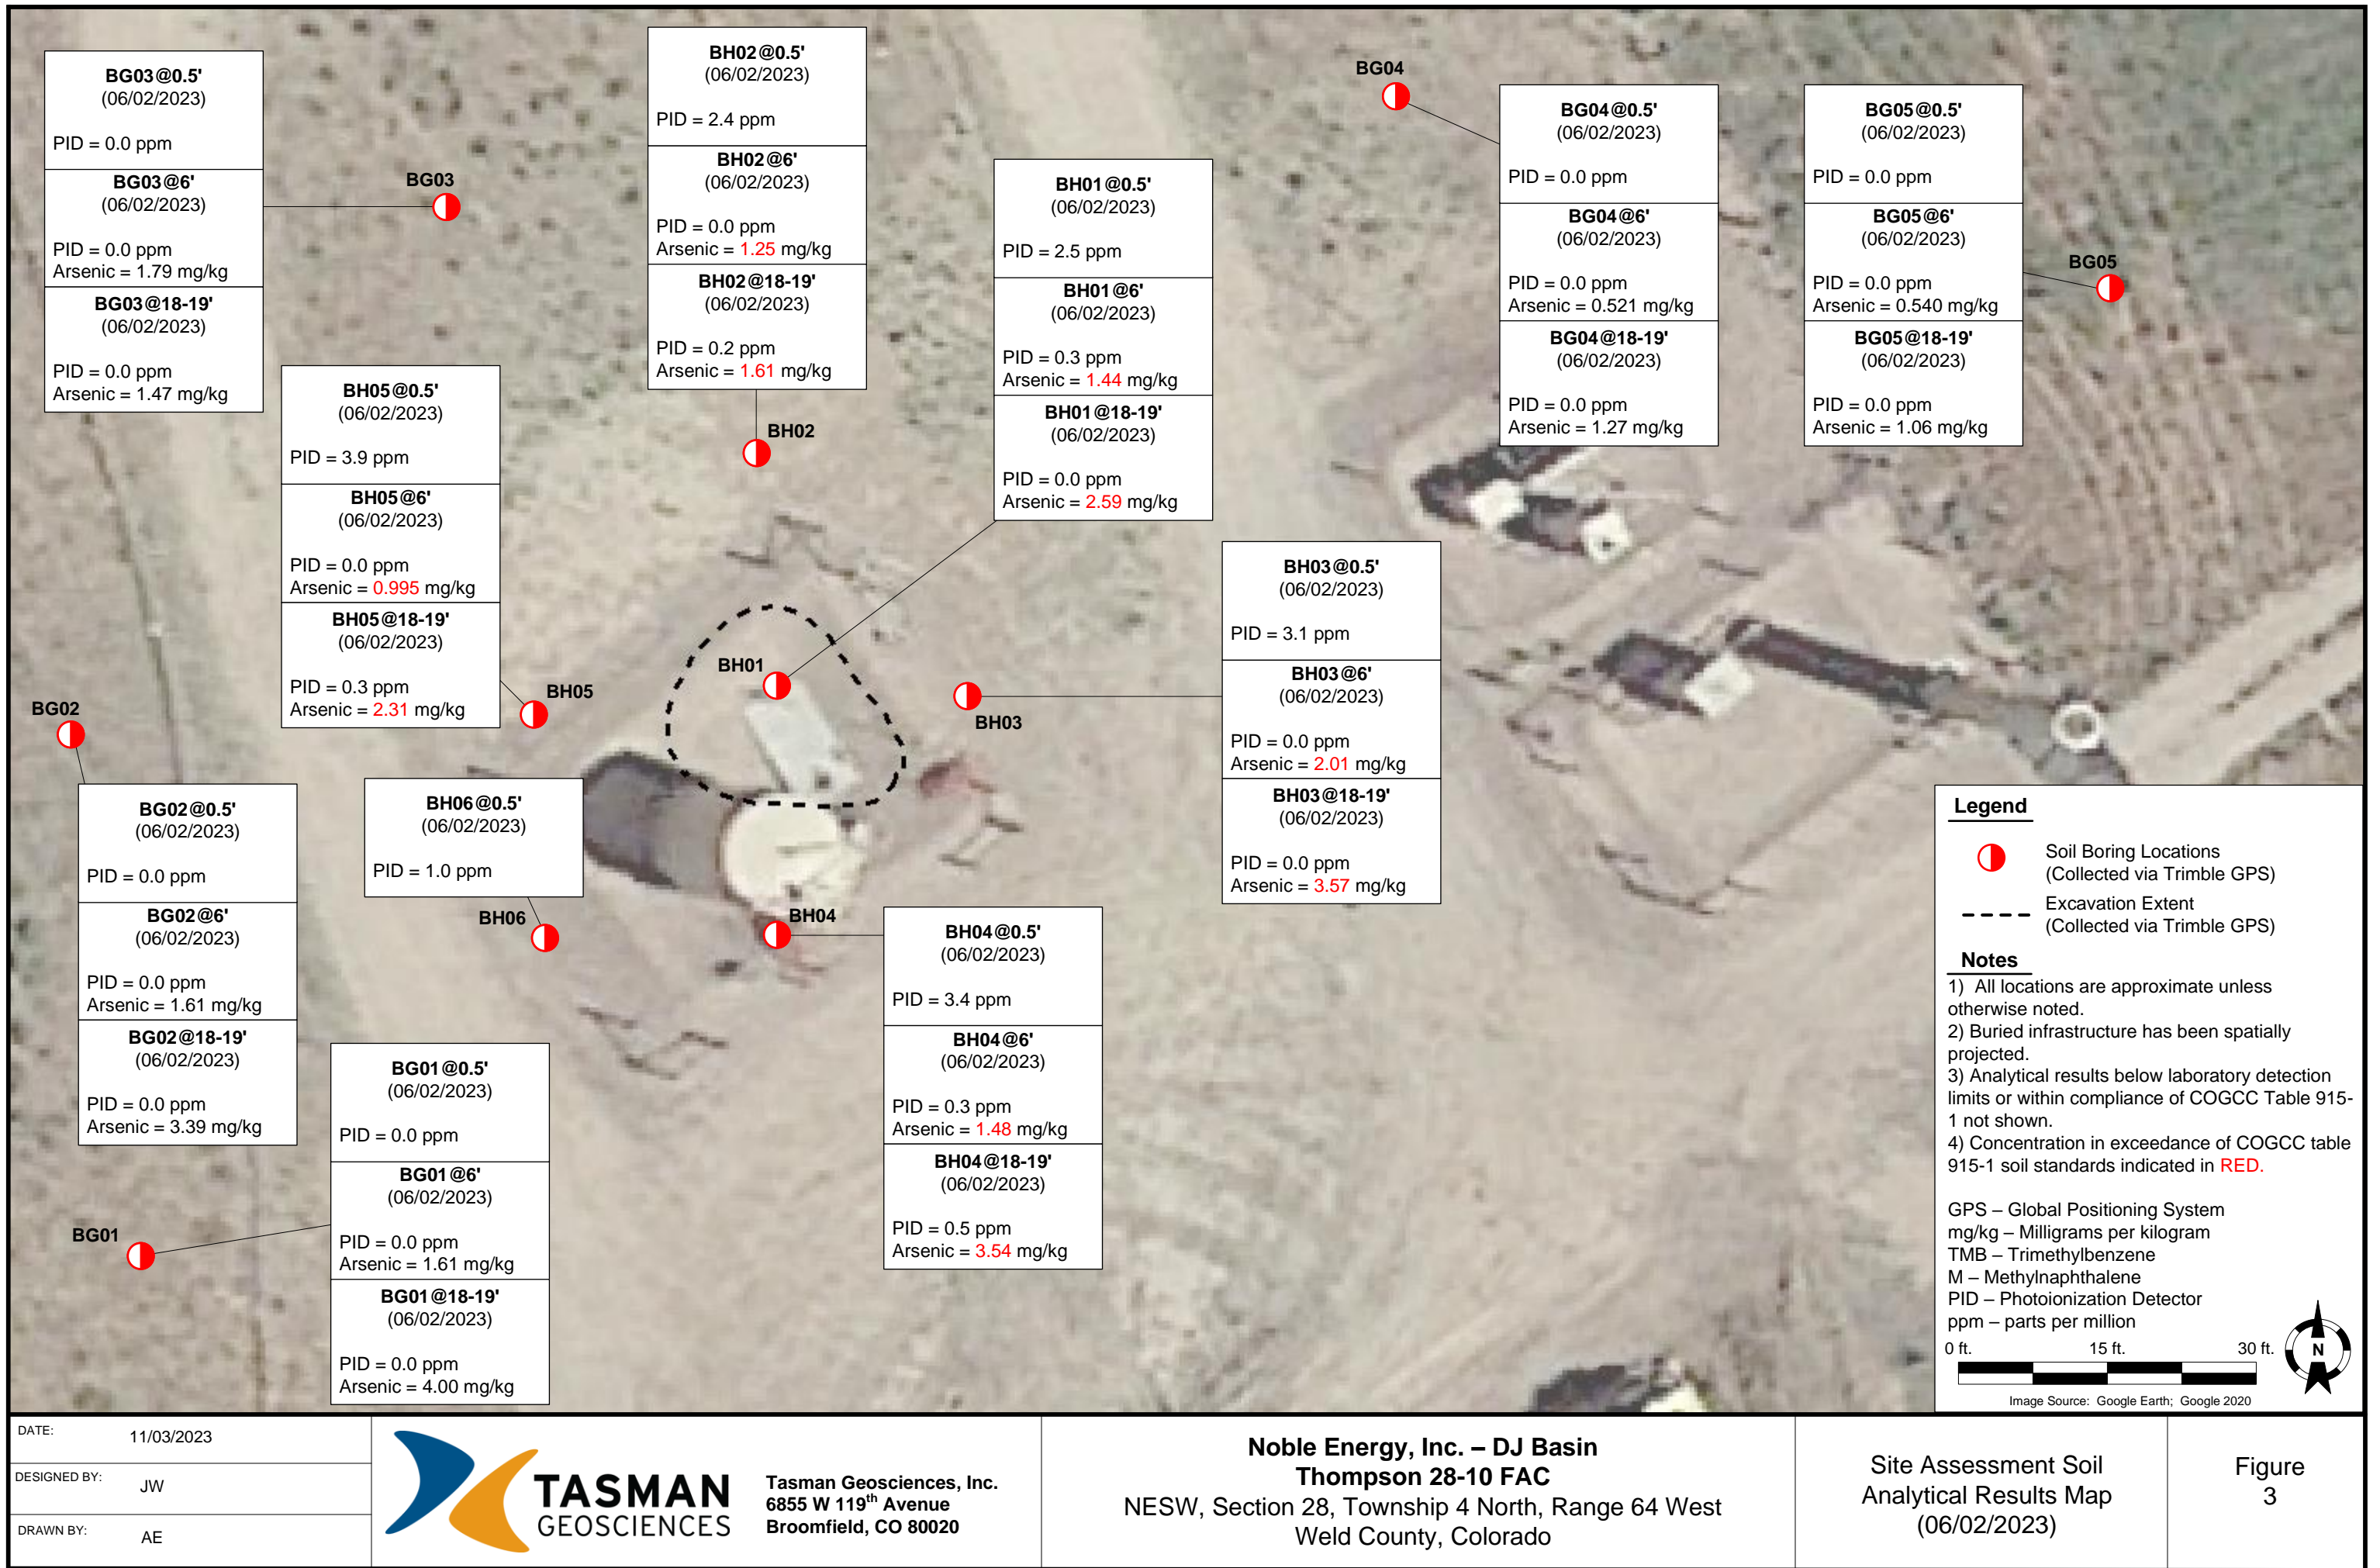

DATE:	11/03/2023
DESIGNED BY:	JW
DRAWN BY:	AE



TASMAN
GEOSCIENCES

Tasman Geosciences, Inc.
6855 W 119th Avenue
Broomfield, CO 80020

Noble Energy, Inc. – DJ Basin
Thompson 28-10 FAC
NESW, Section 28, Township 4 North, Range 64 West
Weld County, Colorado

Site Assessment Soil
Analytical Results Map
(06/02/2023)

Figure
3



TASMAN

6855 W. 119th Ave.
Broomfield, CO 80020

CLIENT: Noble

LOGGED BY: Dennis Gray

PROJECT MANAGER: Jake Whritenour

DRILLING CONTRACTOR: Tasman

DRILLING EQUIPMENT: AMS PowerProbe

DRILL BIT SIZE (INCHES): 2.375"

DATE STARTED - COMPLETED: 6/2/23 - 6/2/23

TOTAL WELL DEPTH (FT. BGS): 19

DEPTH TO WATER (FT. BGS): 11'

Thompson 28-10 Facility

BORING / WELL ID: BH01


LOCATION: Weld County, Colorado

LATITUDE (NAD 83): 40.280700816

LONGITUDE (NAD 83): -104.55962025

CASING ELEVATION (FT. AMSL): 4741.45

GROUND ELEVATION (FT. AMSL): 4741.58

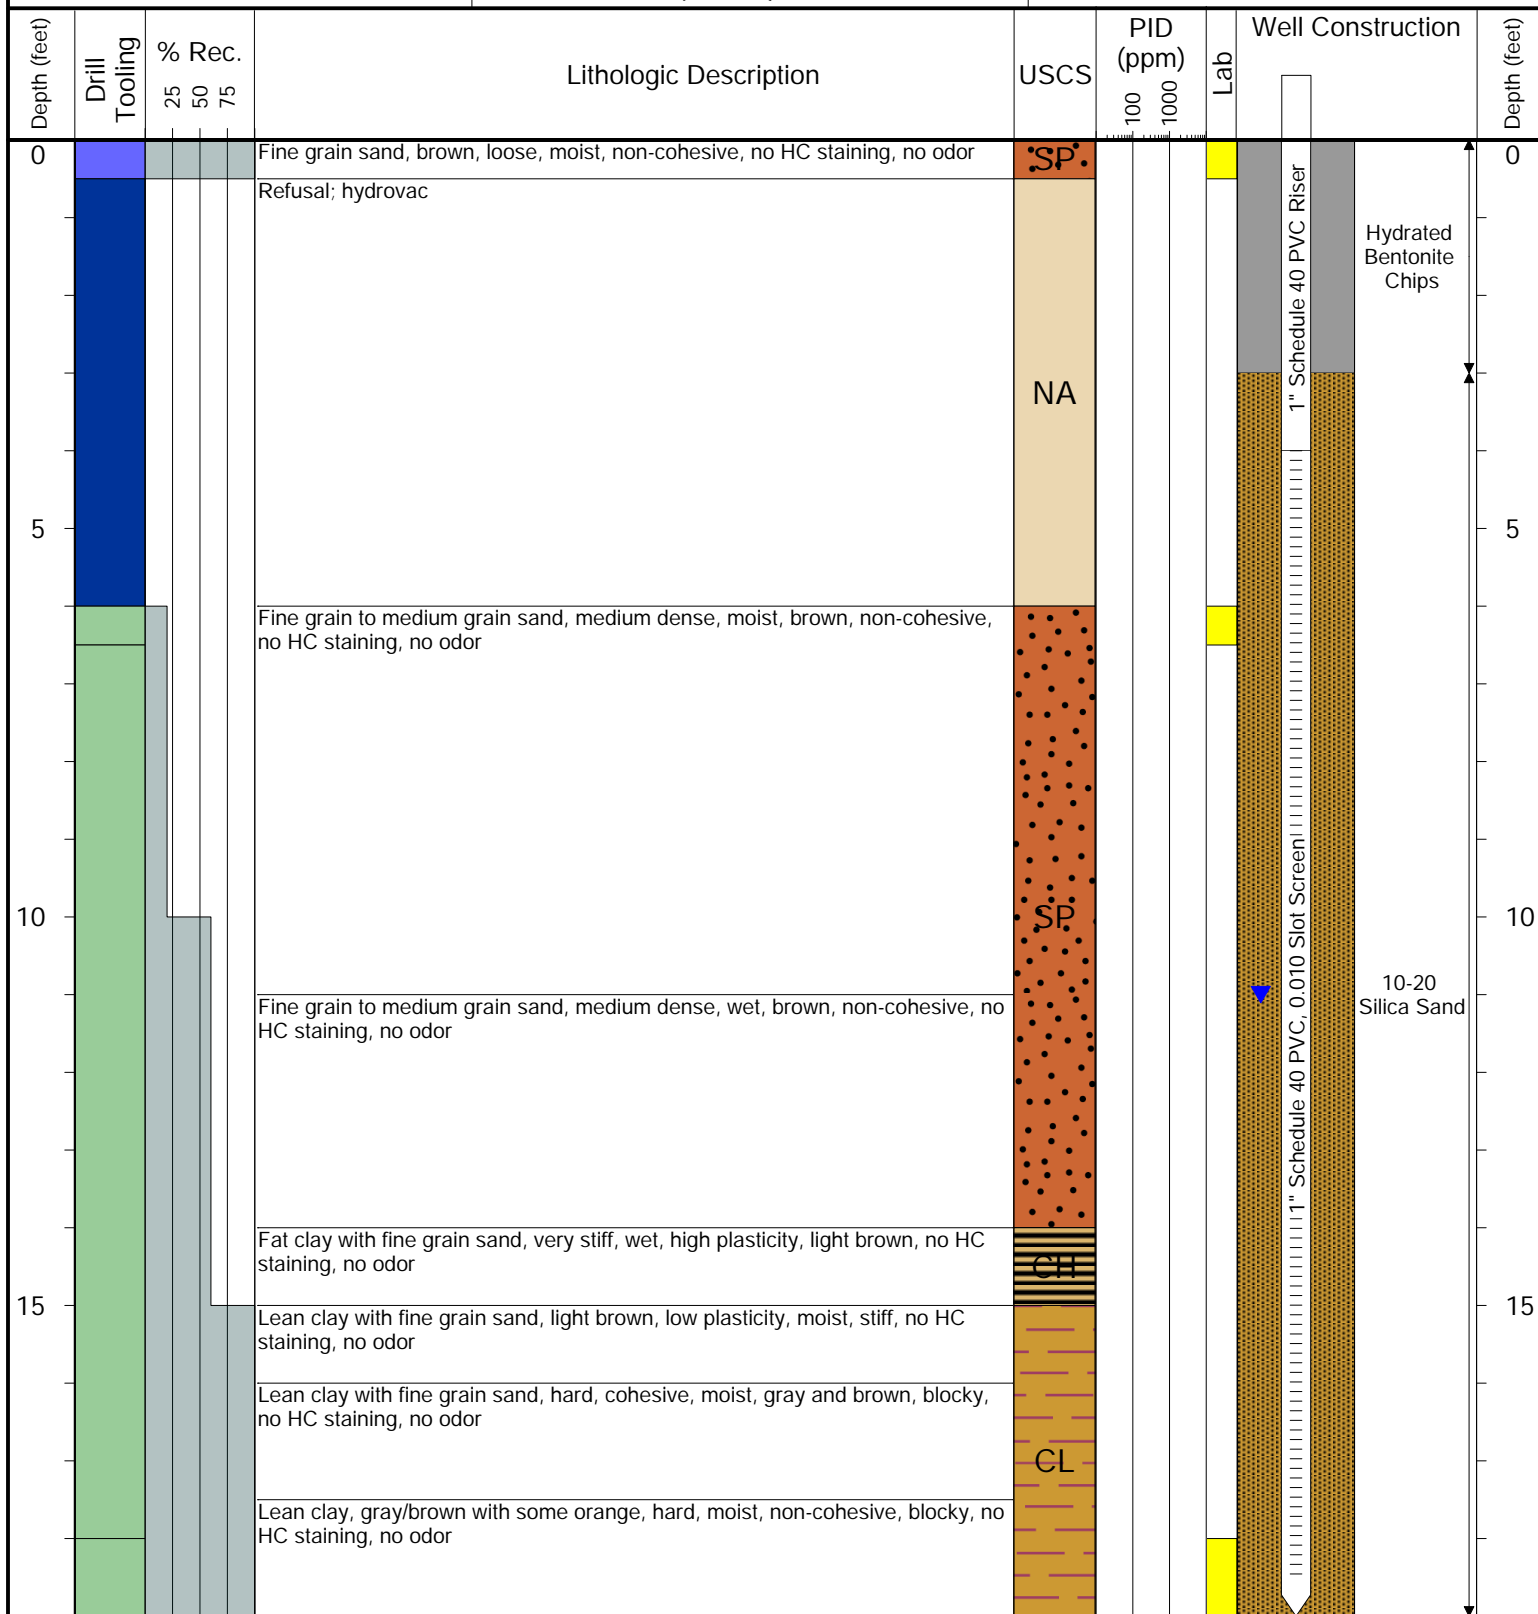

Drilling / Sample Method:

Macro-Core

Hollow Stem Auger

Hydrovac

Hand Auger

Laboratory Sample Types:

Geotechnical Lab

Analytical Chemistry Lab

Geotechnical & Analytical Chemistry Lab



TASMAN

6855 W. 119th Ave.
Broomfield, CO 80020

CLIENT: Noble

LOGGED BY: Dennis Gray

PROJECT MANAGER: Jake Whritenour

DRILLING CONTRACTOR: Tasman

DRILLING EQUIPMENT: AMS PowerProbe

DRILL BIT SIZE (INCHES): 2.375"

DATE STARTED - COMPLETED: 6/2/23 - 6/2/23

TOTAL WELL DEPTH (FT. BGS): 19

DEPTH TO WATER (FT. BGS): 12' ▼

Thompson 28-10 Facility

BORING / WELL ID: BH02


LOCATION: Weld County, Colorado

LATITUDE (NAD 83): 40.2807631243

LONGITUDE (NAD 83): -104.559620222

CASING ELEVATION (FT. AMSL): 4742.57

GROUND ELEVATION (FT. AMSL): 4742.83

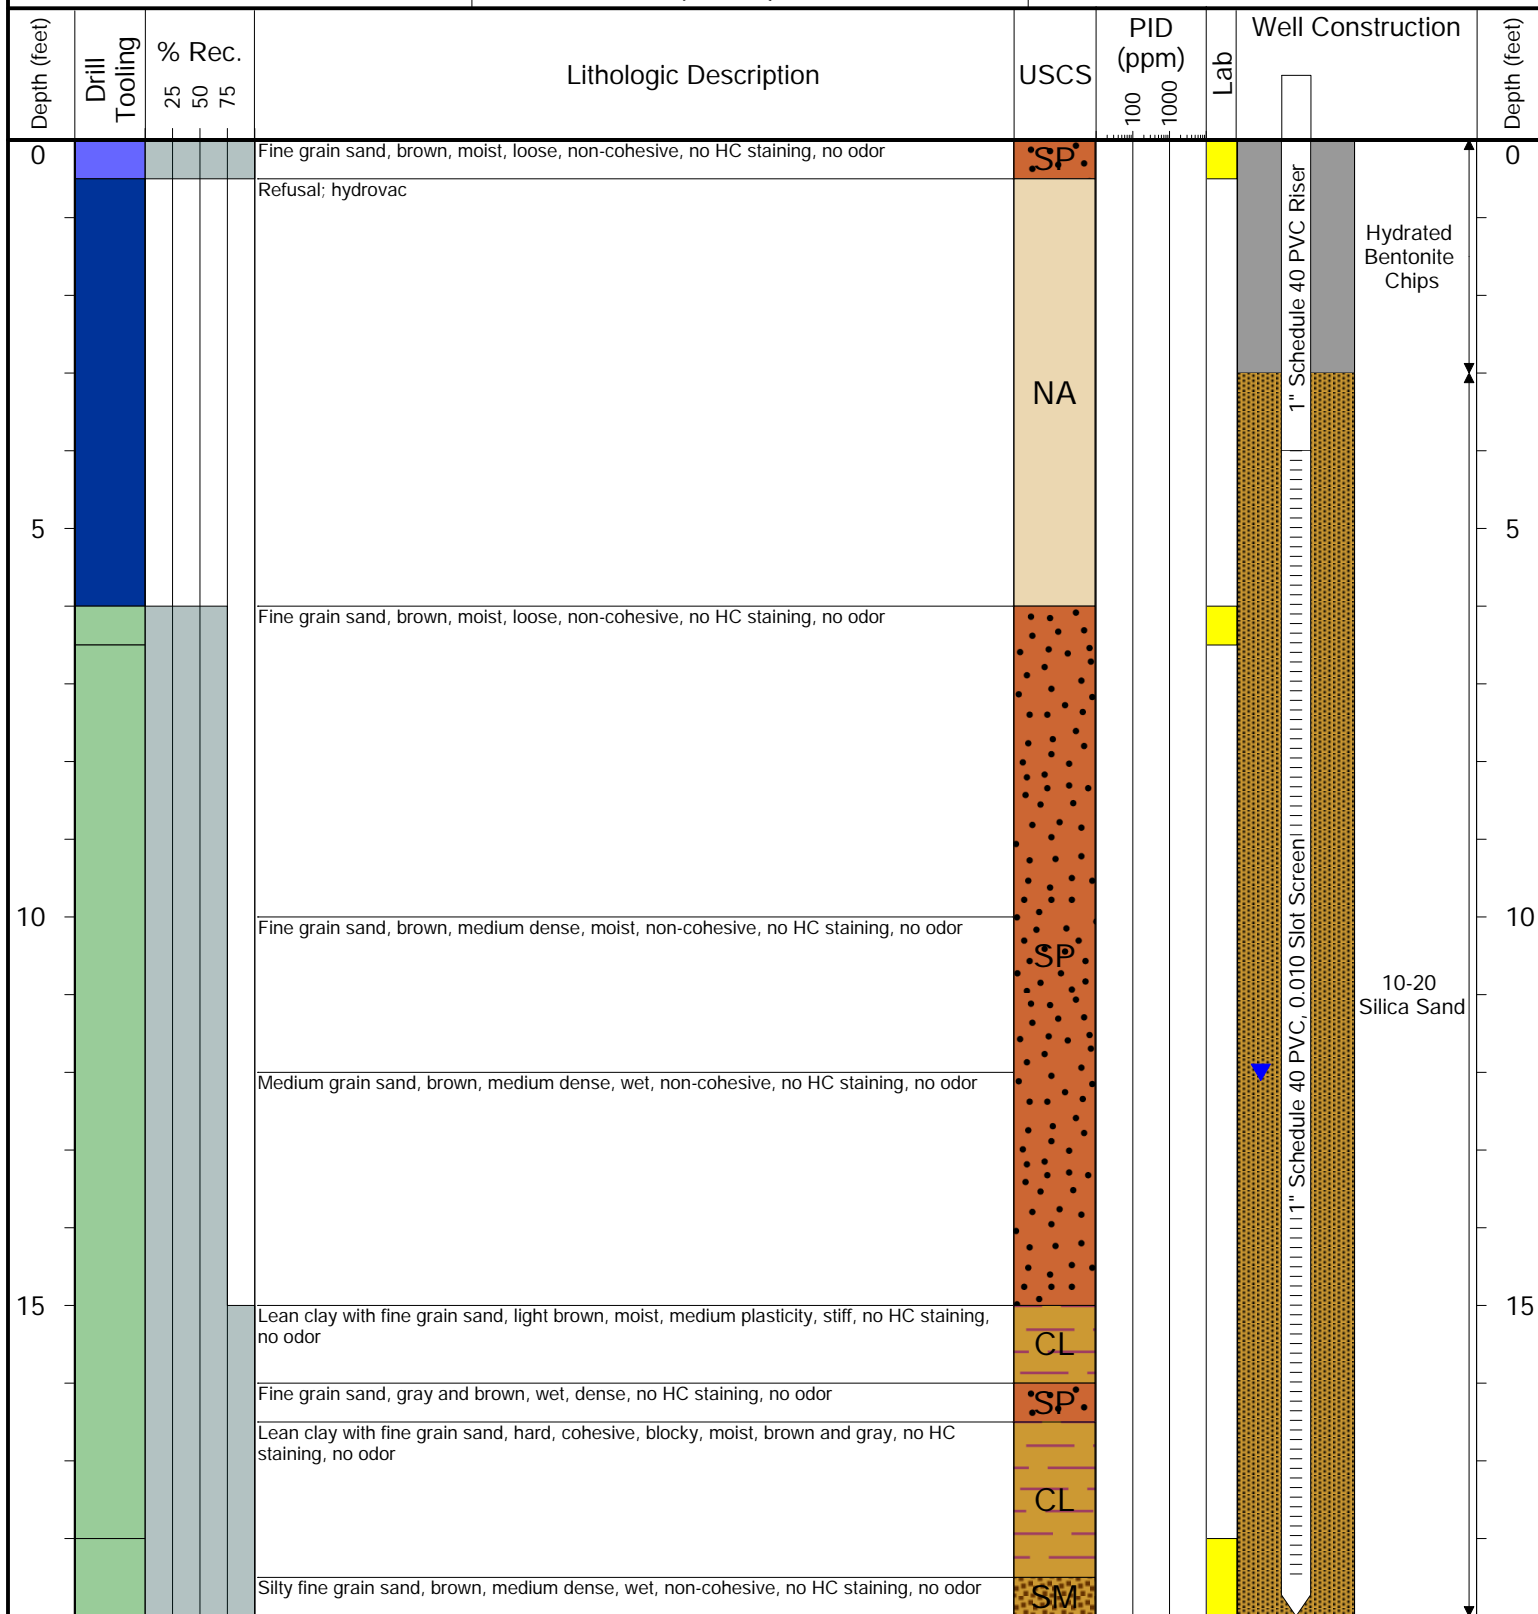

Drilling / Sample Method:

Macro-Core

Hollow Stem Auger

Hydrovac

Hand Auger

Laboratory Sample Types:

Geotechnical Lab

Analytical Chemistry Lab

Geotechnical & Analytical Chemistry Lab



TASMAN

6855 W. 119th Ave.
Broomfield, CO 80020

CLIENT: Noble

LOGGED BY: Dennis Gray

PROJECT MANAGER: Jake Whritenour

DRILLING CONTRACTOR: Tasman

DRILLING EQUIPMENT: AMS PowerProbe

DRILL BIT SIZE (INCHES): 2.375"

DATE STARTED - COMPLETED: 6/2/23 - 6/2/23

TOTAL WELL DEPTH (FT. BGS): 19

DEPTH TO WATER (FT. BGS): 10'

Thompson 28-10 Facility

BORING / WELL ID: BH03


LOCATION: Weld County, Colorado

LATITUDE (NAD 83): 40.2807005968

LONGITUDE (NAD 83): -104.559538149

CASING ELEVATION (FT. AMSL): 4740.56

GROUND ELEVATION (FT. AMSL): 4740.73

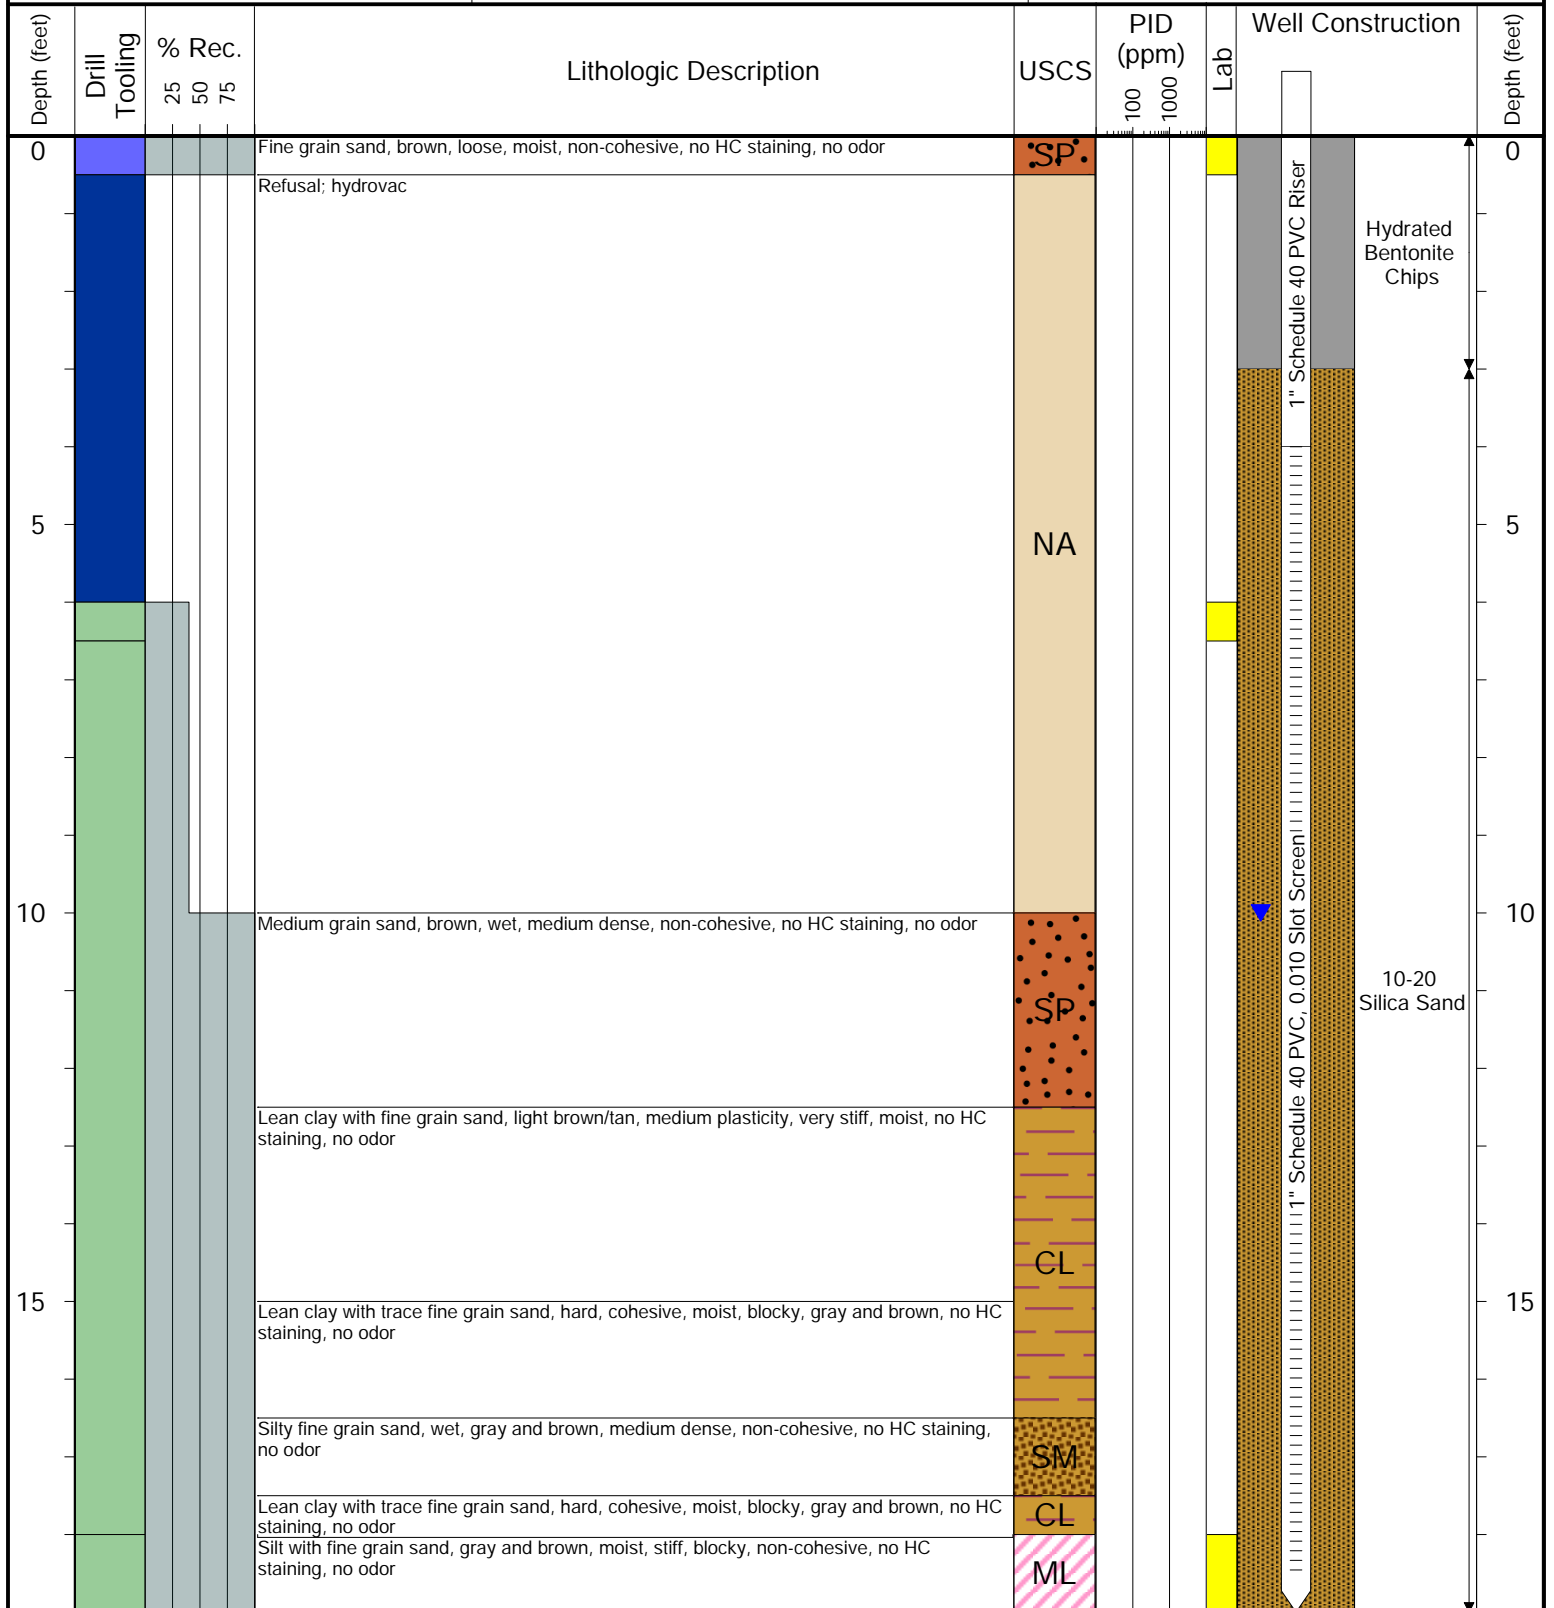

Drilling / Sample Method:

Macro-Core
Hollow Stem Auger
Hydrovac
Hand Auger

Laboratory Sample Types:

Geotechnical Lab
Analytical Chemistry Lab
Geotechnical & Analytical Chemistry Lab



TASMAN

6855 W. 119th Ave.
Broomfield, CO 80020

CLIENT: Noble

LOGGED BY: Dennis Gray

PROJECT MANAGER: Jake Whritenour

DRILLING CONTRACTOR: Tasman

DRILLING EQUIPMENT: AMS PowerProbe

DRILL BIT SIZE (INCHES): 2.375"

DATE STARTED - COMPLETED: 6/2/23 - 6/2/23

TOTAL WELL DEPTH (FT. BGS): 19

DEPTH TO WATER (FT. BGS): 10'

Thompson 28-10 Facility

BORING / WELL ID: BH04


LOCATION: Weld County, Colorado

LATITUDE (NAD 83): 40.2806394075

LONGITUDE (NAD 83): -104.55961978

CASING ELEVATION (FT. AMSL): 4740.18

GROUND ELEVATION (FT. AMSL): 4740.34

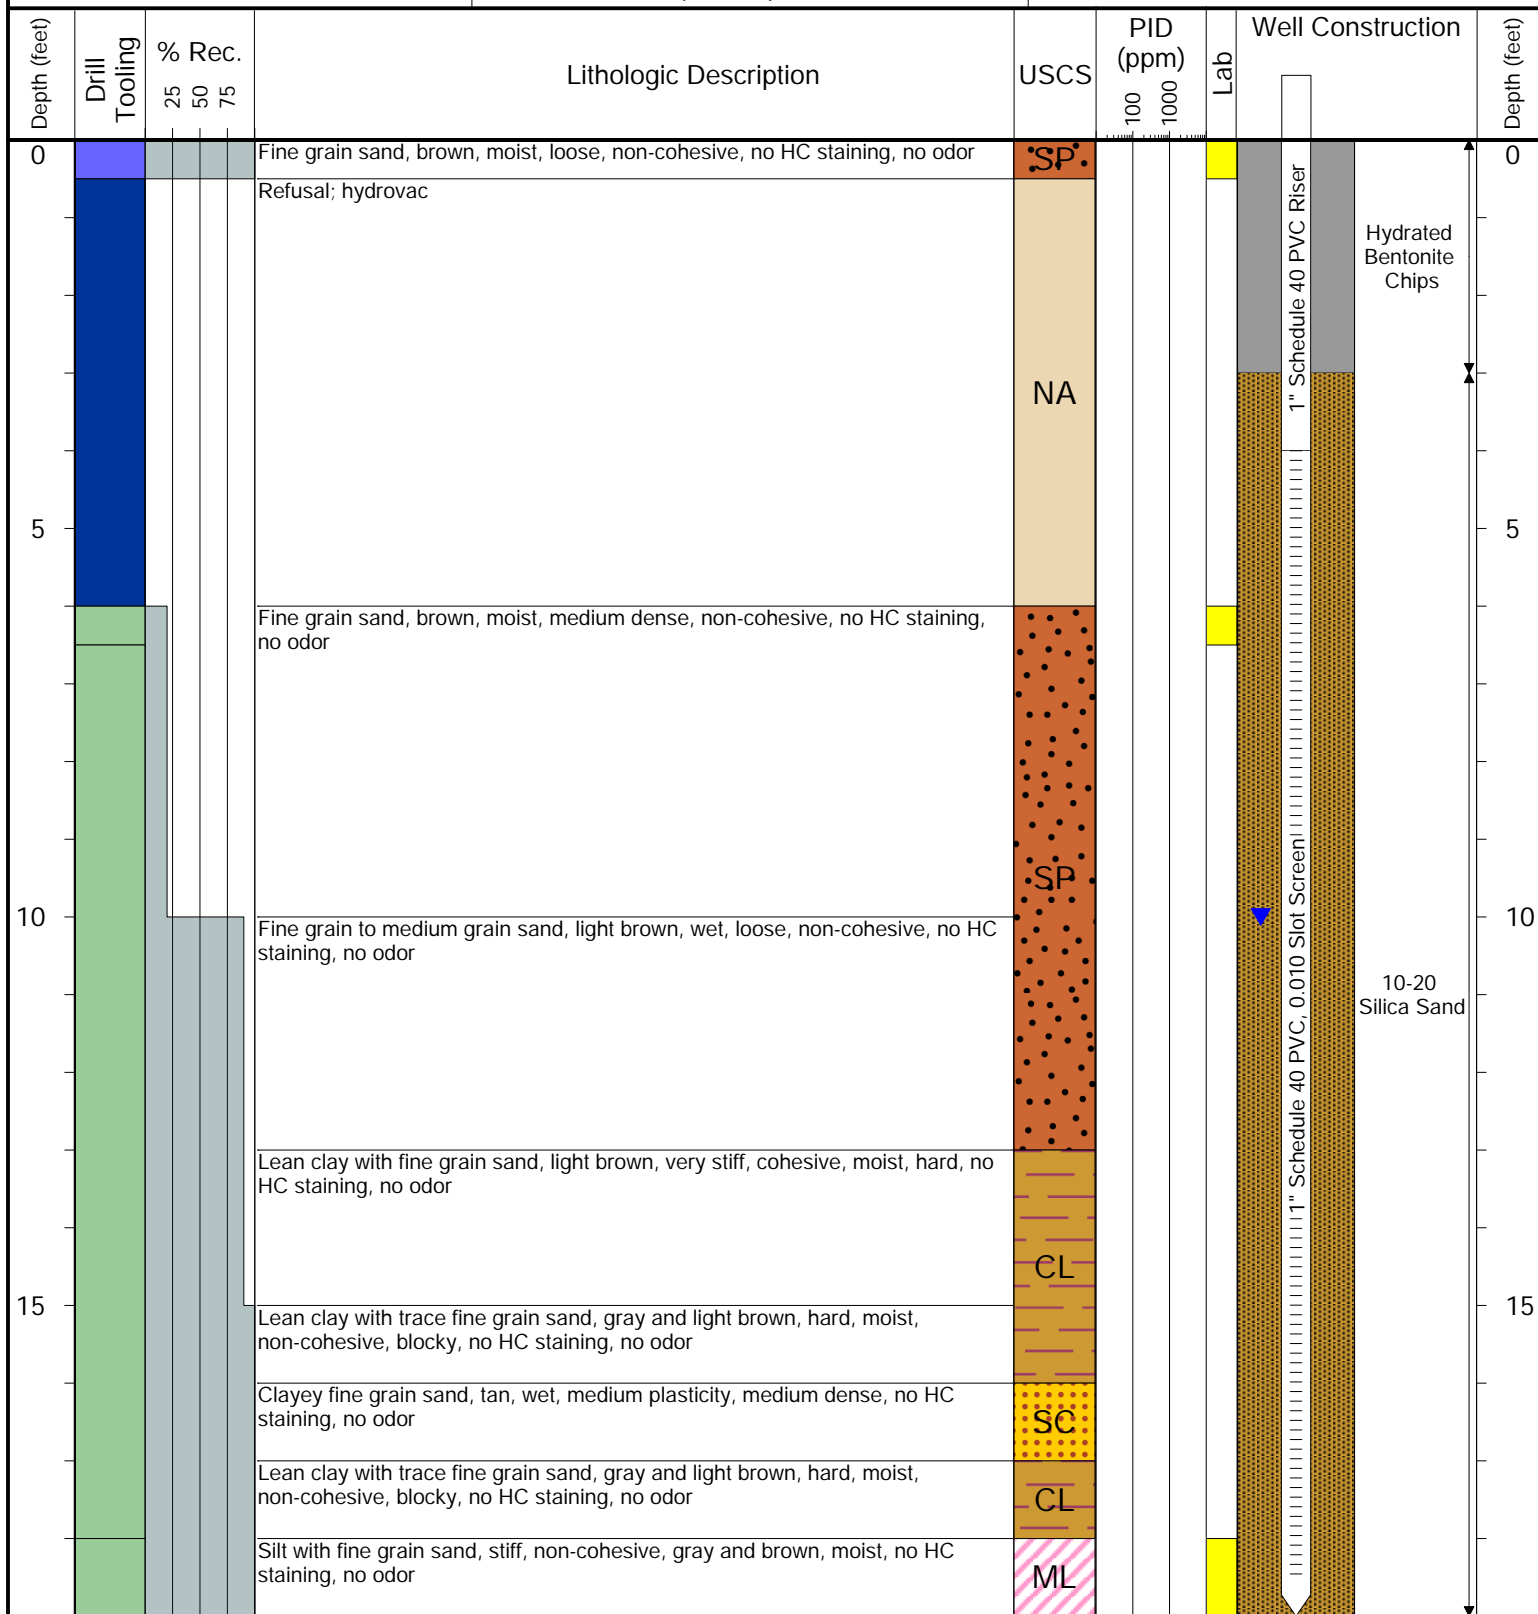

Drilling / Sample Method:

Macro-Core

Hollow Stem Auger

Hydrovac

Hand Auger

Laboratory Sample Types:

Geotechnical Lab

Analytical Chemistry Lab

Geotechnical & Analytical Chemistry Lab



TASMAN

6855 W. 119th Ave.
Broomfield, CO 80020

CLIENT: Noble

LOGGED BY: Dennis Gray

PROJECT MANAGER: Jake Whritenour

DRILLING CONTRACTOR: Tasman

DRILLING EQUIPMENT: AMS PowerProbe

DRILL BIT SIZE (INCHES): 2.375"

DATE STARTED - COMPLETED: 6/2/23 - 6/2/23

TOTAL WELL DEPTH (FT. BGS): 19

DEPTH TO WATER (FT. BGS): 10.5'

Thompson 28-10 Facility

BORING / WELL ID: BH05


LOCATION: Weld County, Colorado

LATITUDE (NAD 83): 40.2807012222

LONGITUDE (NAD 83): -104.55970248

CASING ELEVATION (FT. AMSL): 4741.49

GROUND ELEVATION (FT. AMSL): 4741.65

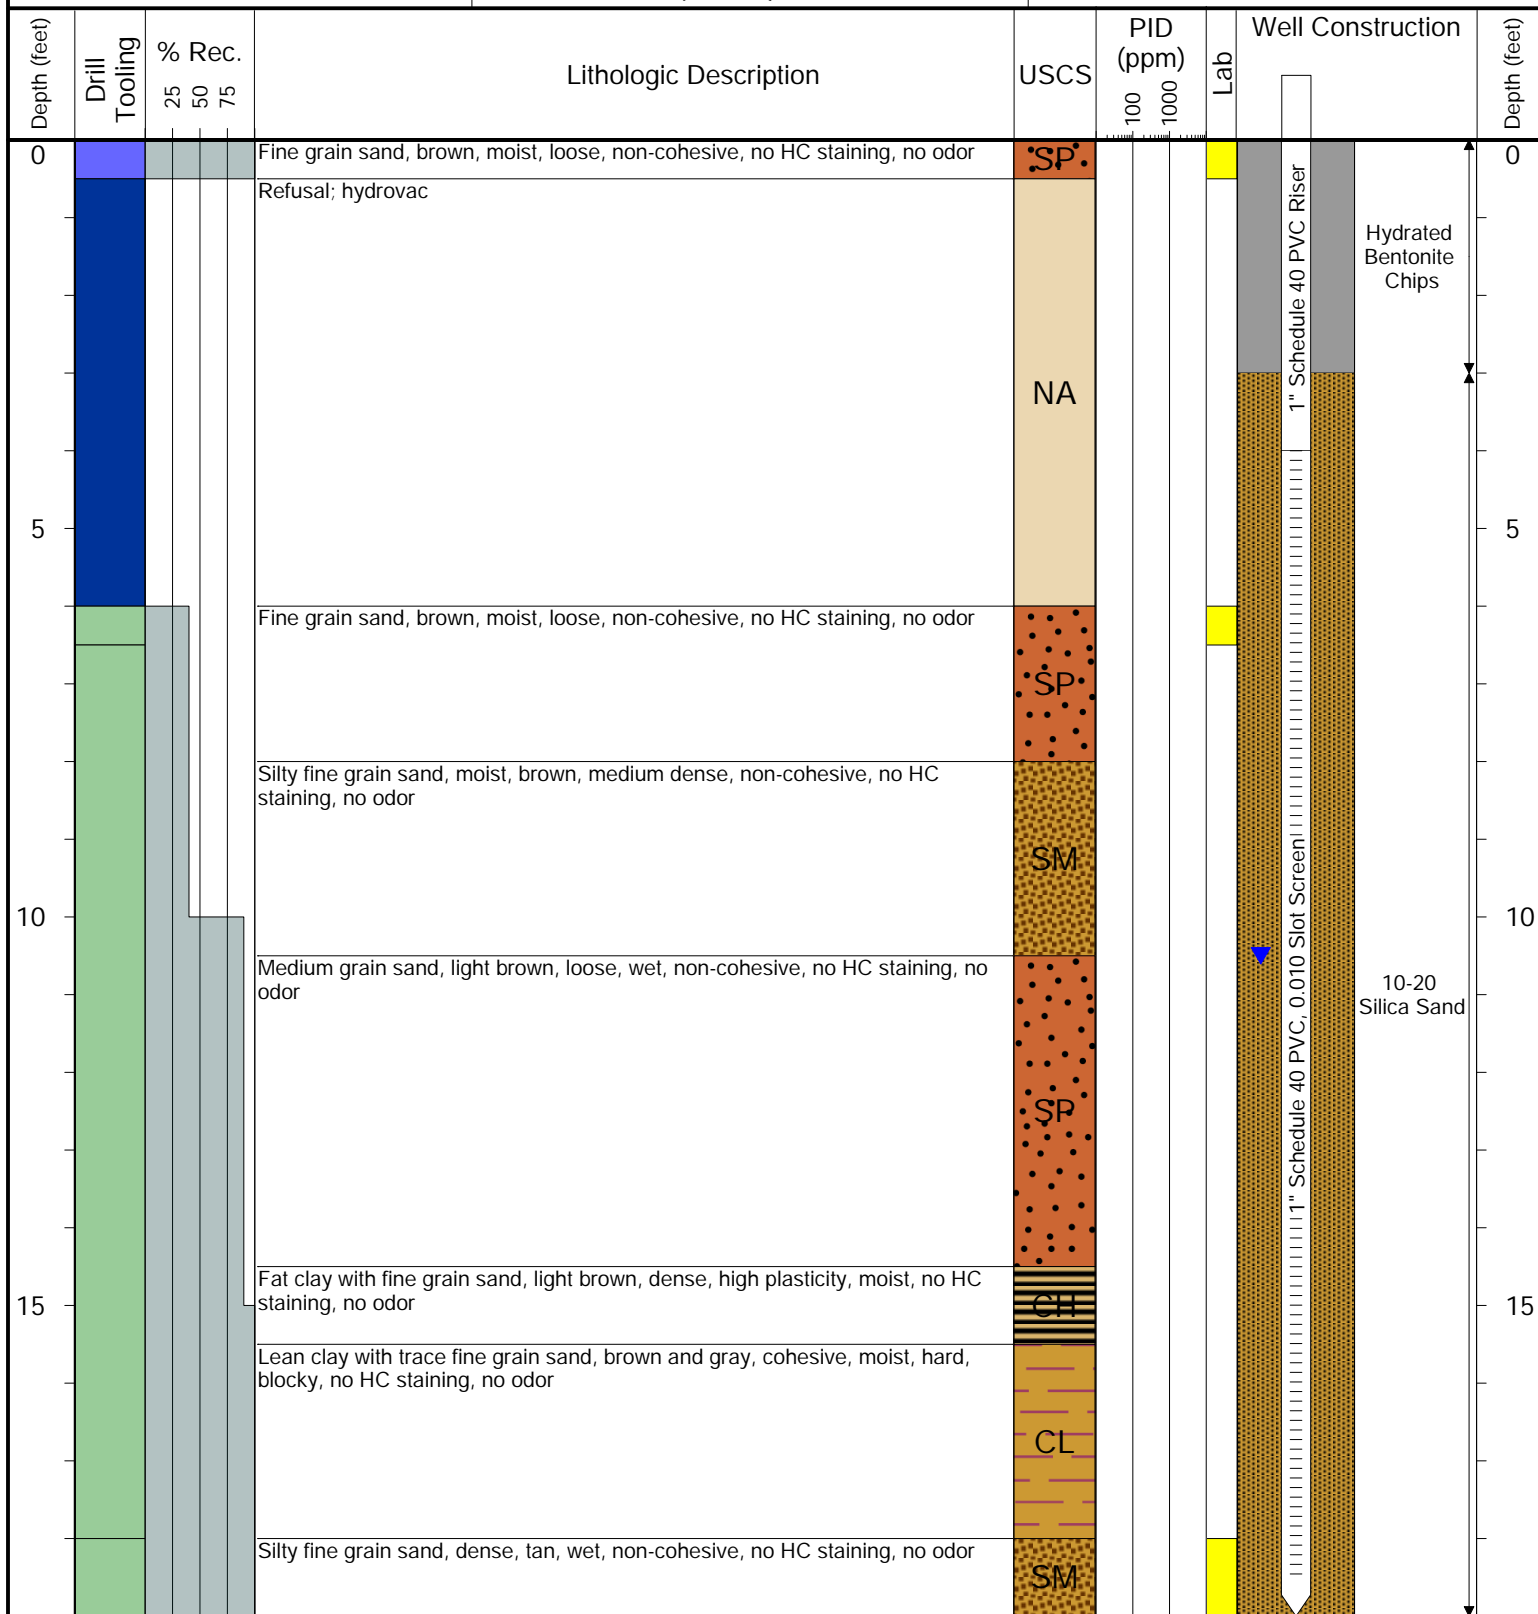

Drilling / Sample Method:

Macro-Core

Hollow Stem Auger

Hydrovac

Hand Auger

Laboratory Sample Types:

Geotechnical Lab

Analytical Chemistry Lab

Geotechnical & Analytical Chemistry Lab



TASMAN

6855 W. 119th Ave.
Broomfield, CO 80020

CLIENT: Noble

LOGGED BY: Dennis Gray

PROJECT MANAGER: Jake Whritenour

DRILLING CONTRACTOR: Tasman

DRILLING EQUIPMENT: AMS PowerProbe

DRILL BIT SIZE (INCHES): 2.375"

DATE STARTED - COMPLETED: 6/2/23 - 6/2/23

TOTAL WELL DEPTH (FT. BGS): 19

DEPTH TO WATER (FT. BGS): 10'

Thompson 28-10 Facility

BORING / WELL ID: BH06


LOCATION: Weld County, Colorado

LATITUDE (NAD 83): 40.2806392506

LONGITUDE (NAD 83): -104.559703816

CASING ELEVATION (FT. AMSL): 4740.28

GROUND ELEVATION (FT. AMSL): 4740.51

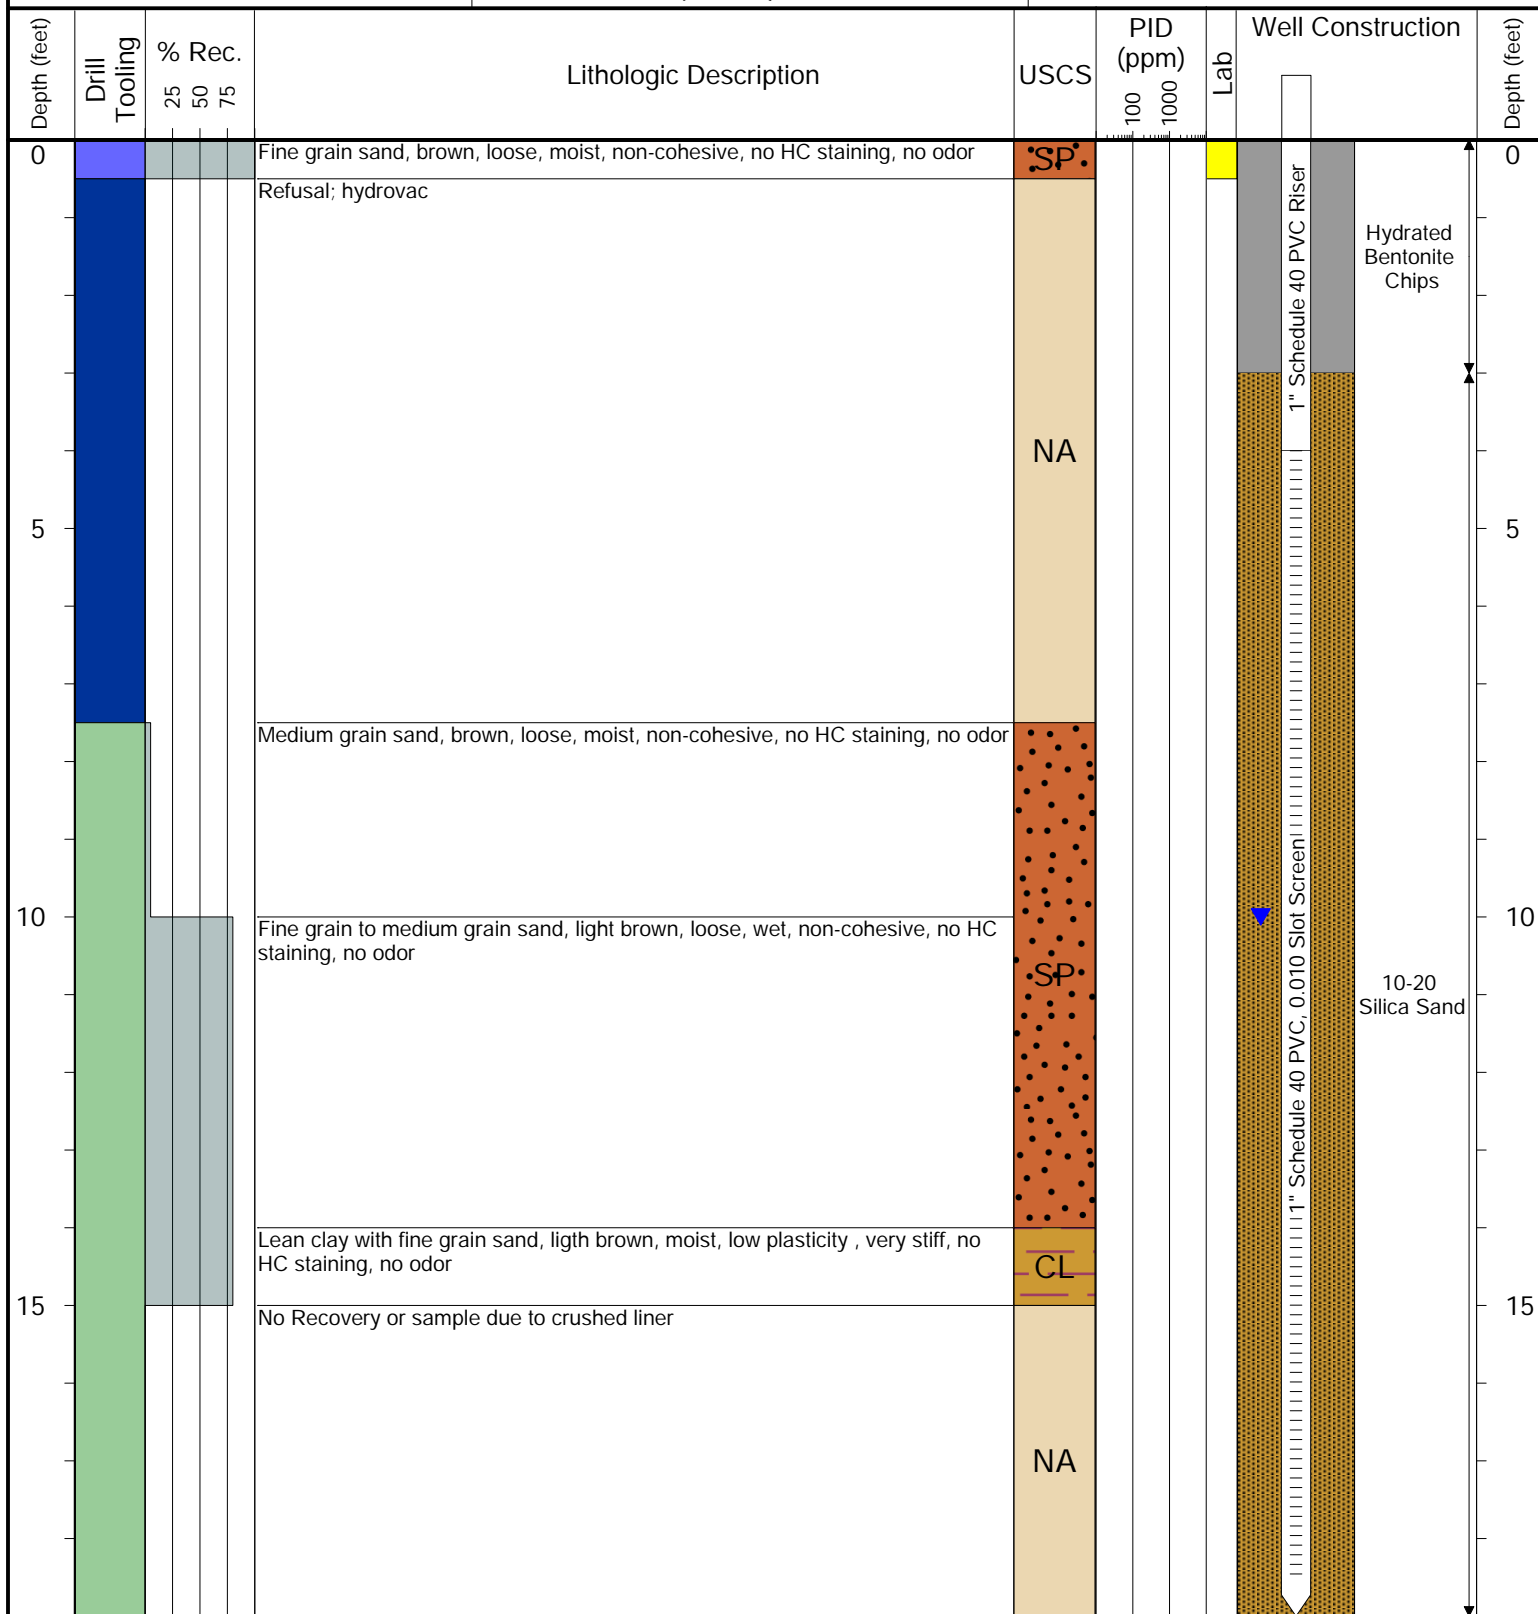

Drilling / Sample Method:

Macro-Core

Hollow Stem Auger

Hydrovac

Hand Auger

Laboratory Sample Types:

Geotechnical Lab

Analytical Chemistry Lab

Geotechnical & Analytical Chemistry Lab



TANK BATTERY DECOMMISSIONING FORM

SITE NAME: Thompson 28-10							DATE: 2/27/2023	REM. PROJECT #: 25228	WEATHER: Clear 40s	
SITE DIRECTIONS: 40 & 53 right through gate and past tank battery to facility							CLIENT: Noble			
LEGALS AND LAT/LONG: 40.280708, -104.559630							TASMAN PERSONNEL: Martin Medeiros			
SOIL TYPES:							SURFACE GRADIENT:			
SOIL SAMPLING							FACILITY INFRASTRUCTURE			
Date/Time	Soil Sample ID	PID (ppm)	Visual	Olfactory	Photo?	Grab or Lab Sample?	EQUIPMENT	Quantity		
							Above Ground Storage Tank (AST)	1		
2/27/2023 13:25	SEP01-FL@3.5'	0.2	HC Staining	No Odor	Yes	Lab	Buried or Partially Buried Vessel	1		
2/27/2023 14:00	SEP01-DL@4'	.2	No Staining	HC Odor	Yes	Grab	Separator	1		
2/27/2023 13:30	MH01@0.5'	0.6	No Staining	No Odor	Yes	Grab	Emission Control Device (ECD)	1		
2/27/2023 13:32	MH02@0.5'	0.3	No Staining	No Odor	Yes	Grab	Dump Line	1		
2/27/2023 13:35	Flare01@0.5'	0.3	No Staining	No Odor	Yes	Grab	Wellhead			
2/27/2023 14:20	AST01@0.5'	0.0	No Staining	No Odor	Yes	Lab	Flowline			
3/2/2023 10:50	SS01@2.5'	0.4	No Staining	No Odor	Yes	On-Hold	Other:			
3/2/2023 10:52	SS02@2.5'	1.0	No Staining	No Odor	Yes	Lab	Soil Loads Removed			
3/2/2023 10:53	SS03@2.5'	0.6	No Staining	No Odor	Yes	On-Hold	IMPACTED SOIL IDENTIFIED?			
3/2/2023 10:55	SS04@2.5'	1.0	No Staining	No Odor	Yes	On-Hold	ESTIMATED VOLUME OF IMPACTS:			
3/2/2023 11:00	FS01@5.5'	0.7	No Staining	No Odor	Yes	Lab	Date	Number	CY	
							Total Removed	0	0	
							Disposal Facility:			
							Groundwater Recovery			
							DATE GW ENCOUNTERED:		DEPTH:	
							GROUNDWATER IN CONTACT WITH IMPACTED SOIL?			
							LNAPL OR SHEEN OBSERVED ON GW?			
GROUNDWATER SAMPLING							Date	BBLS		
Date/Time	Groundwater Sample ID	Depth Collected	Turbid?	Sheen?	Odor?	Photo?				
							Total Removed	0		
							Disposal Facility:			



Client: Noble



Date: 2/28/2023

Daily Forecast/Weather: Clear 40s Personnel: Martin Medeiros

Description of Activities:

[illegible]

Photographic Log

											
Equipment ID: SEP01-FL@3.5'		Equipment Type: Separator		Equipment ID: MH01@0.5'		Equipment Type:					
Material: Steel		Volume:		Contents: Oil/Gas/Water		Material:		Volume:		Contents:	
Notes/Conditions:						Notes/Conditions:					

Photographic Log


Equipment ID: MH02 @ 0.5'

Equipment Type: Partially Buried Vault

Material: Concrete

Volume:
Contents: Produced Water

Notes/Conditions:

Equipment ID: Flare01 @ 0.5'

Equipment Type: Emission Control Device



Material: Concrete

Volume:
Contents:
Notes/Conditions:

Photographic Log

											
Equipment ID: SEP01-DL@4'		Equipment Type: Dump Line		Equipment ID: AST01@0.5'		Equipment Type: Above Ground Storage Tank					
Material: Steel		Volume:		Contents: Produced Water		Material: Steel		Volume:		Contents: Crude Oil	
Notes/Conditions: Sample collected by Back hoe, poor soil grade						Notes/Conditions:					

Photographic Log

					
Equipment ID: SS01 @2.5'		Equipment Type: Partially Buried Vault			
Material: Concrete	Volume:	Contents: Produced Water			
Notes/Conditions:					

Photographic Log


Equipment ID:SS03@2.5'

Equipment Type:Partially Buried Vault

Material:Concrete

Volume:
Contents:Produced Water

Notes/Conditions:

Equipment ID:SS04

Equipment Type:Partially Buried Vault

Material:Concrete

Volume:
Contents:Produced Water

Notes/Conditions:

Photographic Log

											
						Equipment ID: FS01 @ 5.5'		Equipment Type: Partially Buried Vault			
						Material: Concrete	Volume:	Contents: Produced Water	Material:	Volume:	Contents:
						Notes/Conditions:			Notes/Conditions:		