




Lat40°, Inc. 6250 W. 10th Street, Unit 2, Greeley, CO 970-515-5294

# PLUGGED AND ABANDONED WELL EXHIBIT

## MONFORT #1

SECTION: 24  
TOWNSHIP: 6N  
RANGE: 66W  
6TH. P.M.  
WELD COUNTY, CO

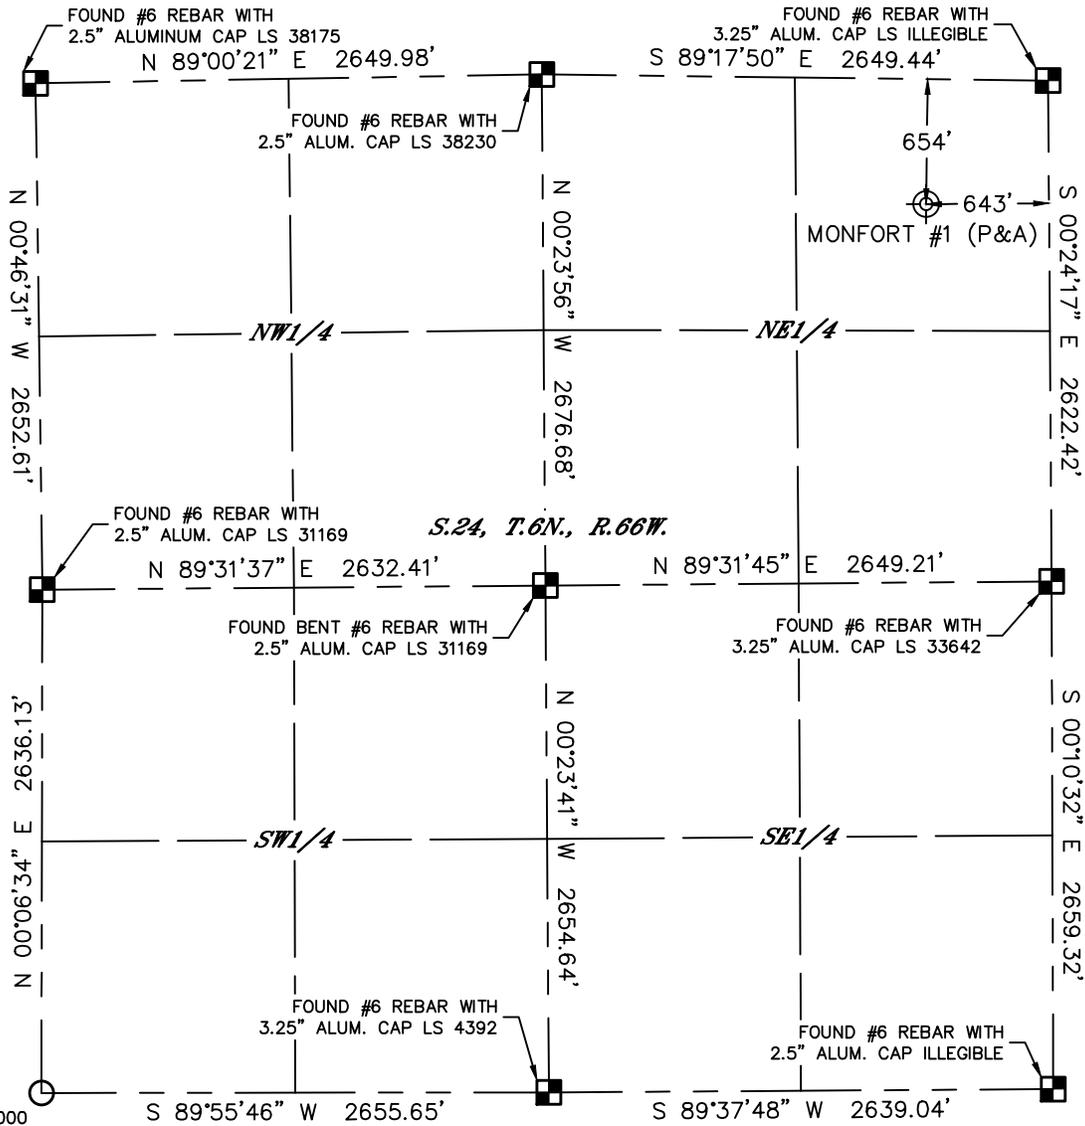


*S.24, T.6N., R.66W.*

CLIENT: PDC ENERGY, INC.				LANDMAN: PAUL MONTVILLE					
INSTRUMENT OPERATOR: CASEY KOHOUT				SURVEY DATE: 8/18/2023		SURFACE USE: CROPLAND			
SHL FOOTAGE		SHL LAT °	SHL LONG °	SHL PDOP	SHL ELEV (FT.)	SHL 1/4/1/4	SHL S-T-R		
654	FNL	643	FEL	40.47925	-104.71819	1.2	4733	NENE	24-6-66
DESCRIPTION: LOCATED EXPOSED WELL. FOUND 9" STEEL PIPE WITH CAP.									

NOTE:

- 1) Bearings shown are Grid Bearings of the Colorado State Plane Coordinate System, North Zone, North American Datum 1983. The lineal dimensions as contained herein are based upon the "U.S. Survey Foot."
- 2) Distances to section lines measured at 90 degrees from said section lines.
- 3) Ground elevations are based on an observed GPS elevation (NAVD 1988 DATUM).
- 4) Latitude and Longitude shown are (NAD 83 DATUM).
- 5) Sectional data as shown hereon is from previous surveys and was not verified for this P&A Exhibit.
- 6) This map does not represent a boundary survey.

- LEGEND
- = ALIQUOT MONUMENT AS DESCRIBED
  - = CALCULATED POSITION
  - = ABANDONED WELL

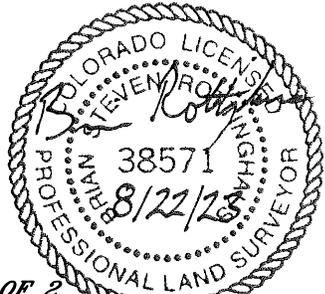



Lat40°, Inc. 6250 W. 10th Street, Unit 2, Greeley, CO 970-515-5294

# PLUGGED AND ABANDONED WELL EXHIBIT

MONFORT #1

SECTION: 24  
TOWNSHIP: 6N  
RANGE: 66W  
6TH. P.M.  
WELD COUNTY, CO  
DATE: 8/18/2023



VIEW NORTH



VIEW WEST



VIEW EAST



VIEW SOUTH