PA Wellbore For State - Vertical

Well Name: Monfort 1

Original Hole

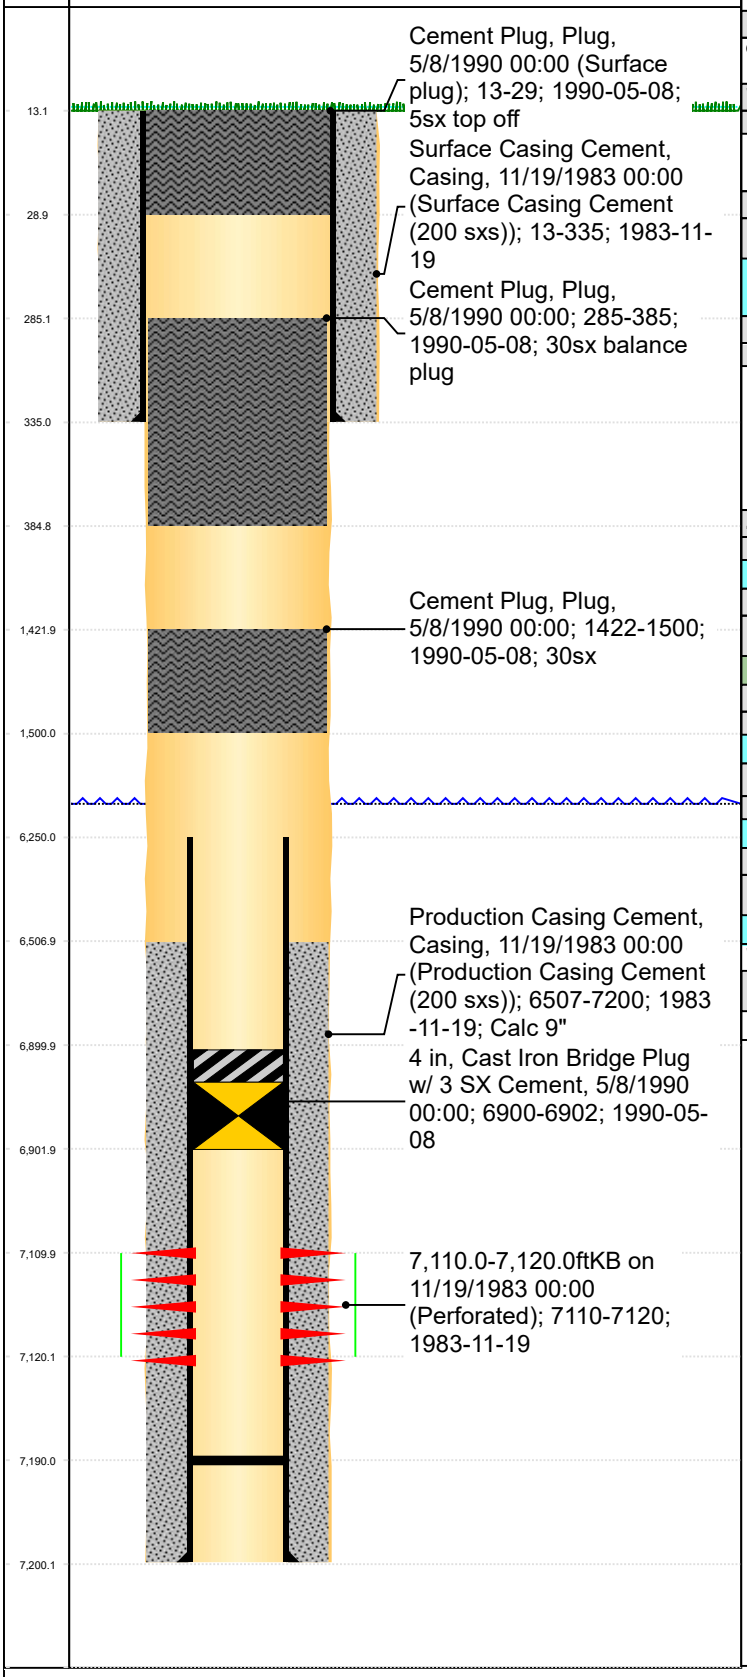

Well Header

Surface UWI	Business Unit	Gov Auth Dist	Prod Tree Loc
0512311435	Rockies		

Orig. KB to Gnd (ft)	Original Spud Date	Abandon Date	Well Sub-Status	High…
13.00	11/5/1983	5/8/1990	PA	N

Comment
Francis Energy Inc.

Surface Location (Congressional)

Qtr 3	Qtr 4	Section	Twnshp	Twnsh…	Range	Rng E/…	Latitude (°)	Longitude (°)
N	E		6	N	66	W		

Wellbore Sections

Section Des	Hole Size (in)	Top Depth (ftKB)	Btm Depth (ftKB)
Surface	12 1/4	13.0	335.0
	7 7/8	335.0	7,200.0

Casing Strings

Csg Des	Run Date	OD (in)	Wt/Len (lb/ft)	Grade	Top Depth (MD) (ftKB)	Set Depth (MD) (ftKB)
Surface		8 5/8	24.00	J-55	13	335
Production Casing		4 1/2	11.60		0	7200

Cement

Des	Start Date	Top (ftKB)	Btm (ftKB)
Surface Casing Cement (200 sxs)	11/19/1983	13.0	335.0
Production Casing Cement (200 sxs)	11/19/1983	6,507.0	7,200.0
Cement Plug	5/8/1990	1,422.0	1,500.0
Surface plug	5/8/1990	13.0	29.0
Cement Plug	5/8/1990	285.0	385.0

Zone Statuses

Zone Name	Status Date	Status	Fluid Type	Job	Prod Method

Perforation Data

Linked Zone	Explosive Type	Entered Shot Total	Top (ftKB)	Btm (ftKB)	Date
Codell, Original Hole			7,110.0	7,120.0	11/19/1983

Stim/Frac Stage

Zone	Start Date	Top (ftKB)	Btm (ftKB)
Codell, Original Hole	11/19/1983	7,110.0	7,120.0

Other In Hole

Run Date	Des	Make	OD (in)	Top (ftKB)	Btm (ftKB)
5/8/1990	Cast Iron Bridge Plug w/ 3 SX Cement		4	6,900.0	6,902.0

Logs

Date	Type	Depth Top (MD) (ftKB)	Btm (ftKB)

Wellbore Plug Back Total Depths

Date	Type	Com	PBTD (ftKB)
11/10/1983			7,190