

Loc. #389519

FIELD NAME WILDCAT - #99999

Spud Date 6/18/1969

Basin DENVER - JULESBURG

Location NENE 30 7N 51W 6

Elevation GL (ft) 4313

Elevation KB (ft) 4323

TD (ft) 4724

PBTD (ft) UNK

Formation Tops

NIOBRARA - 3725'


GREENHORN - 4295'

D SAND - 4528'

J SAND - 4636'

SKULL CREEK - 4719'

AS PLUGGED

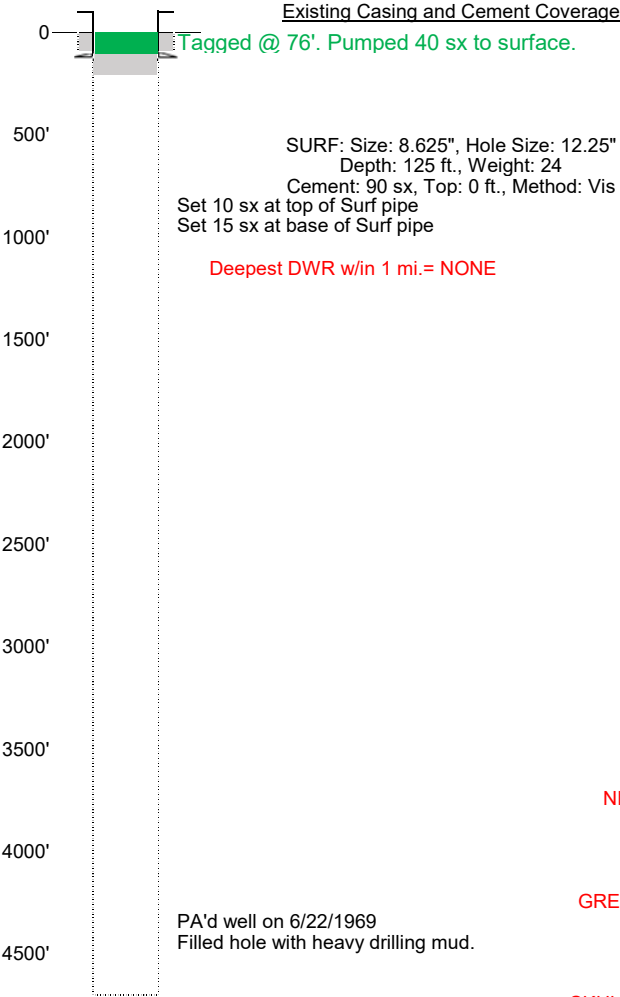

RE-ENTRY TO REPLUG

TD (ft) 4724'

PROPOSED

