


WELL NAME: STATE NORTH PLATTE F-36 FED 25N-20-06 OPERATOR: BONANZA CREEK ENERGY OPERATING COMPANY not to scale
 FIELD: WATTENBERG FORMATION: Niobrara GROUND LEVEL: 4544
 SHL: qtr-qtr NWNW Section 36 Township 5N Range 63W KELLY BUSHING: 4569
 BHL: qtr-qtr NWNW Section 24 Township 5N Range 63W SPUD DATE: 4/8/2024
 COUNTY: WELD STATE: CO API: 05-123-52460 TD DATE: 4/17/2024

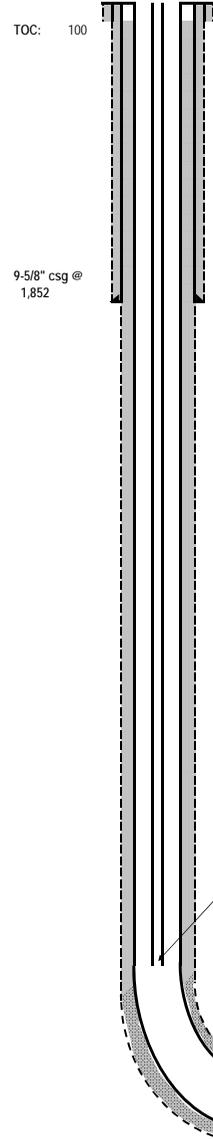

CONDUCTOR CASING
 SIZE: 16"
 WEIGHT: 36.95#
 HOLE SIZE: 26
 CSG DEPTH: 100
 CEMENT: 100 SKS
 TOC: SURFACE

SURFACE CASING
 SIZE: 9-5/8"
 WEIGHT: 36#
 HOLE SIZE: 13-1/2"
 HOLE DEPTH: 1,852
 CSG DEPTH: 1,852
 CEMENT: 836 SKS
 TOC: surface

PRODUCTION CASING
 SIZE: 5-1/2"
 WEIGHT: 20#
 HOLE SIZE: 8-1/2"
 TOTAL DEPTH TVD: 6,341
 TOTAL DEPTH MD: 17,004
 CSG DEPTH: 16,996
 CEMENT: 2695 SKS
 TOC: 100

PRODUCTION TUBING
 SIZE: 2 3/8"
 WEIGHT: 4.7#
 DEPTH: 7,061
 PACKER DEPTH: 7,060

FRAC DATA

537,937	BBLS GELLED FLUID
33	BBLS ACID
17,779	BBLS FRESH WATER
555,749	BBLS TOTAL FLUID

EOT @ 7061

FORMATION TOPS & PERFORATIONS

NIORARA MD	7,028	
PERFORATIONS	7,362	16,946

0	# 30/50 MESH
9,040,536	# 40/70 MESH
7,243,715	# 100 MESH
16,284,251	# TOTAL SAND
49	STAGES

7,362

16,946

Production Csg @ 16996'

MD TD 17,004

49 48 47 46 45 44 43 42 41 40 39 38 37 36 35 34 33 32 31 30 29 28 27 26 25 24 23 22 21 20 19 18 17 16 15 14 13 12 11 10 9 8 7 6 5 4 3 2 1