P&A Wellbore For State

Well Name: Wilson 14-30

Original Hole [Land]

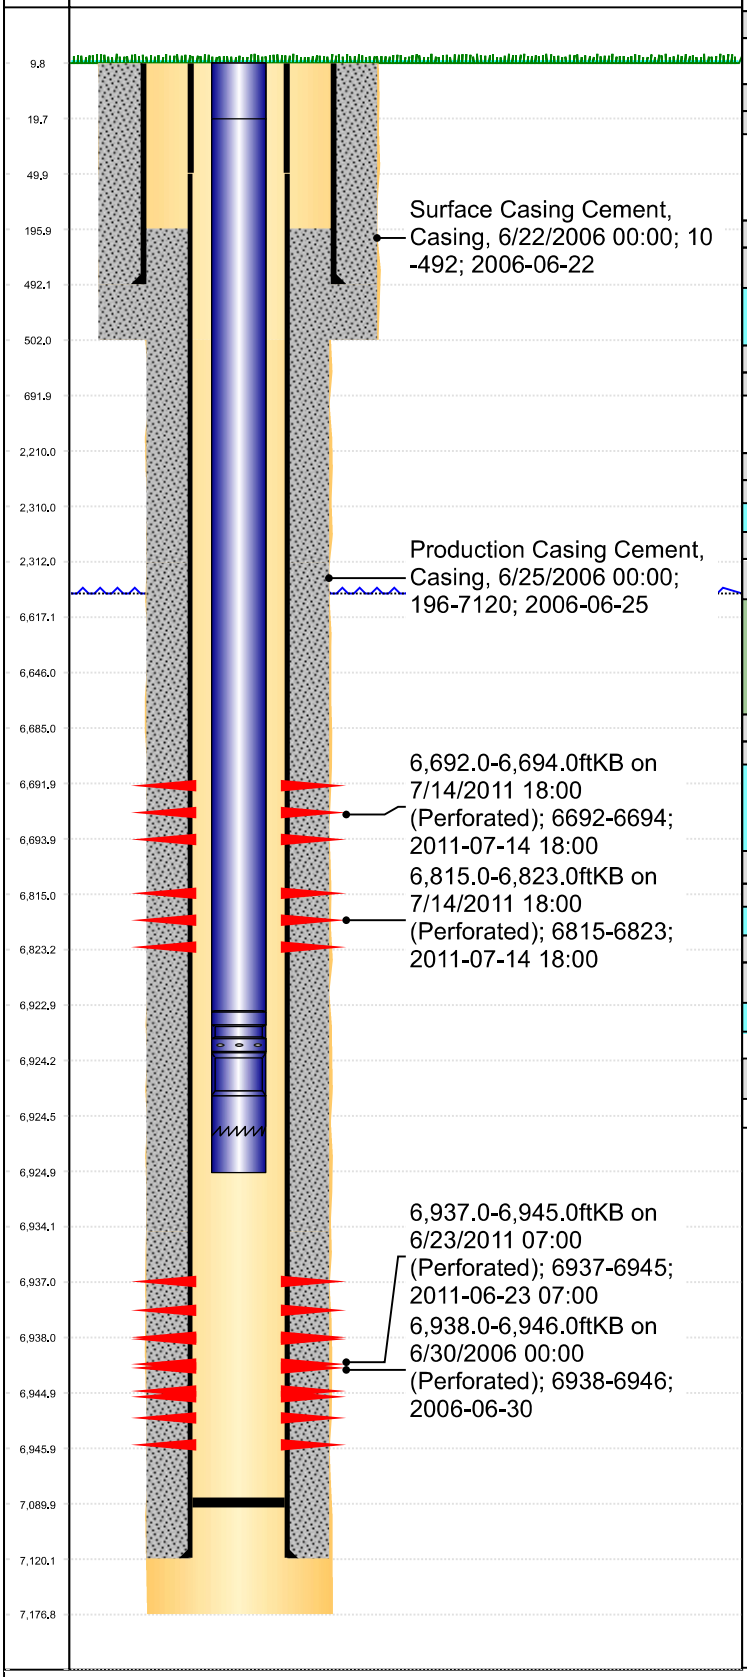

Well Header

Surface UWI	Business Unit	Gov Auth Dist	Prod Tree Loc
0512323903	Rockies	Evans	Land

Orig. KB to Gnd (ft)	Original Spud Date	Abandon Date	Well Sub-Status	High…
10.00	6/21/2006		PR	N

Comment

Surface Location (Congressional)

Qtr 3	Qtr 4	Section	Twnshp	Twnsh…	Range	Rng E/…	Latitude (°)	Longitude (°)
SW	SW	30	7	N	63	W	40.53906	-104.48675

Wellbore Sections

Section Des	Hole Size (in)	Top Depth (ftKB)	Btm Depth (ftKB)
Surface	12 1/4	10.0	502.0
Production	7 7/8	502.0	7,177.0

Casing Strings

Csg Des	Run Date	OD (in)	Wt/Len (lb/ft)	Grade	Top Depth (MD) (ftKB)	Set Depth (MD) (ftKB)
Surface	6/22/2006	8 5/8	24.00	J-55	10	492
Production	6/25/2006	4 1/2	10.50	M-65	10	7120

Cement

Des	Start Date	Top (ftKB)	Btm (ftKB)
	6/22/2006	10.0	492.0
	6/25/2006	196.0	7,120.0

Zone Statuses

Zone Name	Status Date	Status	Fluid Type	Job	Prod Method

Perforation Data

Linked Zone	Explosive Type	Entered Shot Total	Top (ftKB)	Btm (ftKB)	Date
Niobrara_A, Original Hole			6,692.0	6,694.0	7/14/2011
Niobrara_B, Original Hole			6,815.0	6,823.0	7/14/2011
Codell, Original Hole			6,937.0	6,945.0	6/23/2011
Codell, Original Hole			6,938.0	6,946.0	6/30/2006

Stim/Frac Stage

Zone	Start Date	Top (ftKB)	Btm (ftKB)
Codell, Original Hole	7/5/2006		
Codell, Original Hole	7/8/2011		
Niobrara, Original Hole	7/17/2011		

Other In Hole

Run Date	Des	Make	OD (in)	Top (ftKB)	Btm (ftKB)

Logs

Date	Type	Depth Top (MD) (ftKB)	Btm (ftKB)

Wellbore Plug Back Total Depths

Date	Type	Com	PBTD (ftKB)
6/25/2006			7,090