


1320  
735

T1N, R93W, 6th P.M.

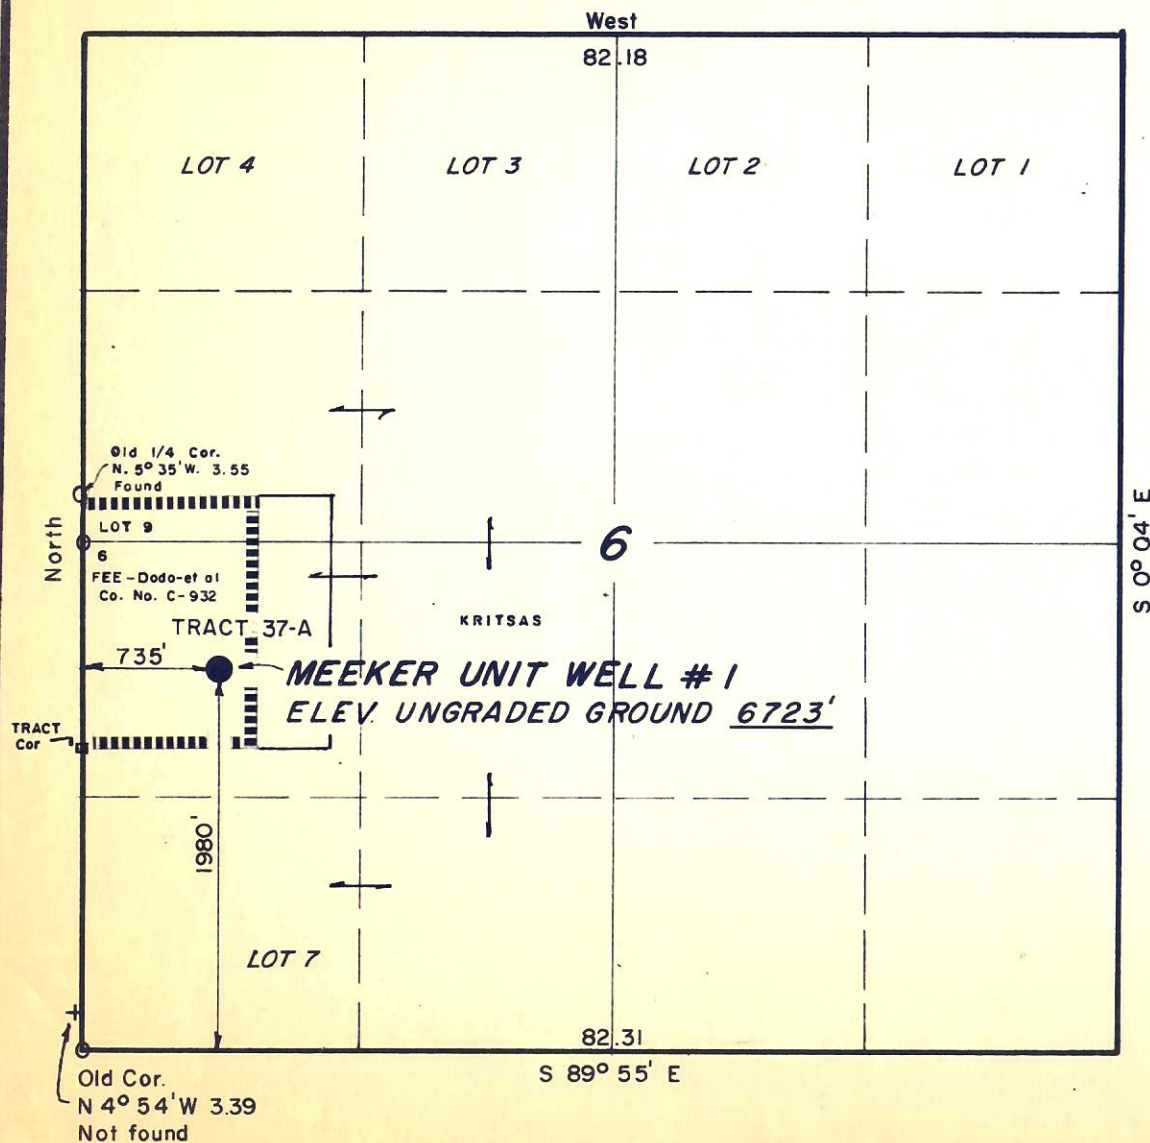

PROJECT  
MOUNTAIN FUEL SUPPLY CO.

Well location, MEEKER UNIT WELL #1,  
located as shown in the NW 1/4 SW 1/4  
(Lot 6) Section 6, T1N, R93W, 6th  
P.M. Rio Blanco County, Colorado.

RECEIVED  
SEP 19 1972  
COLD. OIL & GAS COMS. COMM.



CERTIFICATE

THIS IS TO CERTIFY THAT THE ABOVE PLAT WAS PREPARED FROM  
FIELD NOTES OF ACTUAL SURVEYS MADE BY ME UNDER MY  
SUPERVISION AND THAT THE SAME ARE TRUE AND CORRECT TO THE  
BEST OF MY KNOWLEDGE AND BELIEF.

*Helmut J. Smith*  
REGISTERED LAND SURVEYOR  
REGISTRATION NO. 5839  
STATE OF COLORADO

UINTAH ENGINEERING & LAND SURVEYING  
P.O. BOX Q - 110 EAST - FIRST SOUTH  
VERNAL, UTAH - 84078

SCALE 1" = 1000'	DATE 7 June, 1972
PARTY N.J.M. R.K.D.N.	REFERENCES GLO Plat
WEATHER Fair - Warm	FILE MOUNTAIN FUEL
	DRWG NO. M-10810