


THIS DRAWING AND THE DESIGN IT COVERS ARE CONFIDENTIAL AND REMAIN THE PROPERTY OF ANADARKO PETROLEUM CORPORATION AND SHALL NOT BE DISCLOSED TO OTHERS OR REPRODUCED IN ANY MANNER OR USED FOR ANY PURPOSE WHATSOEVER EXCEPT BY WRITTEN PERMISSION BY THE OWNER.

PERMANENT METER SKID

PERMANENT METHANOL INJECTION SKID

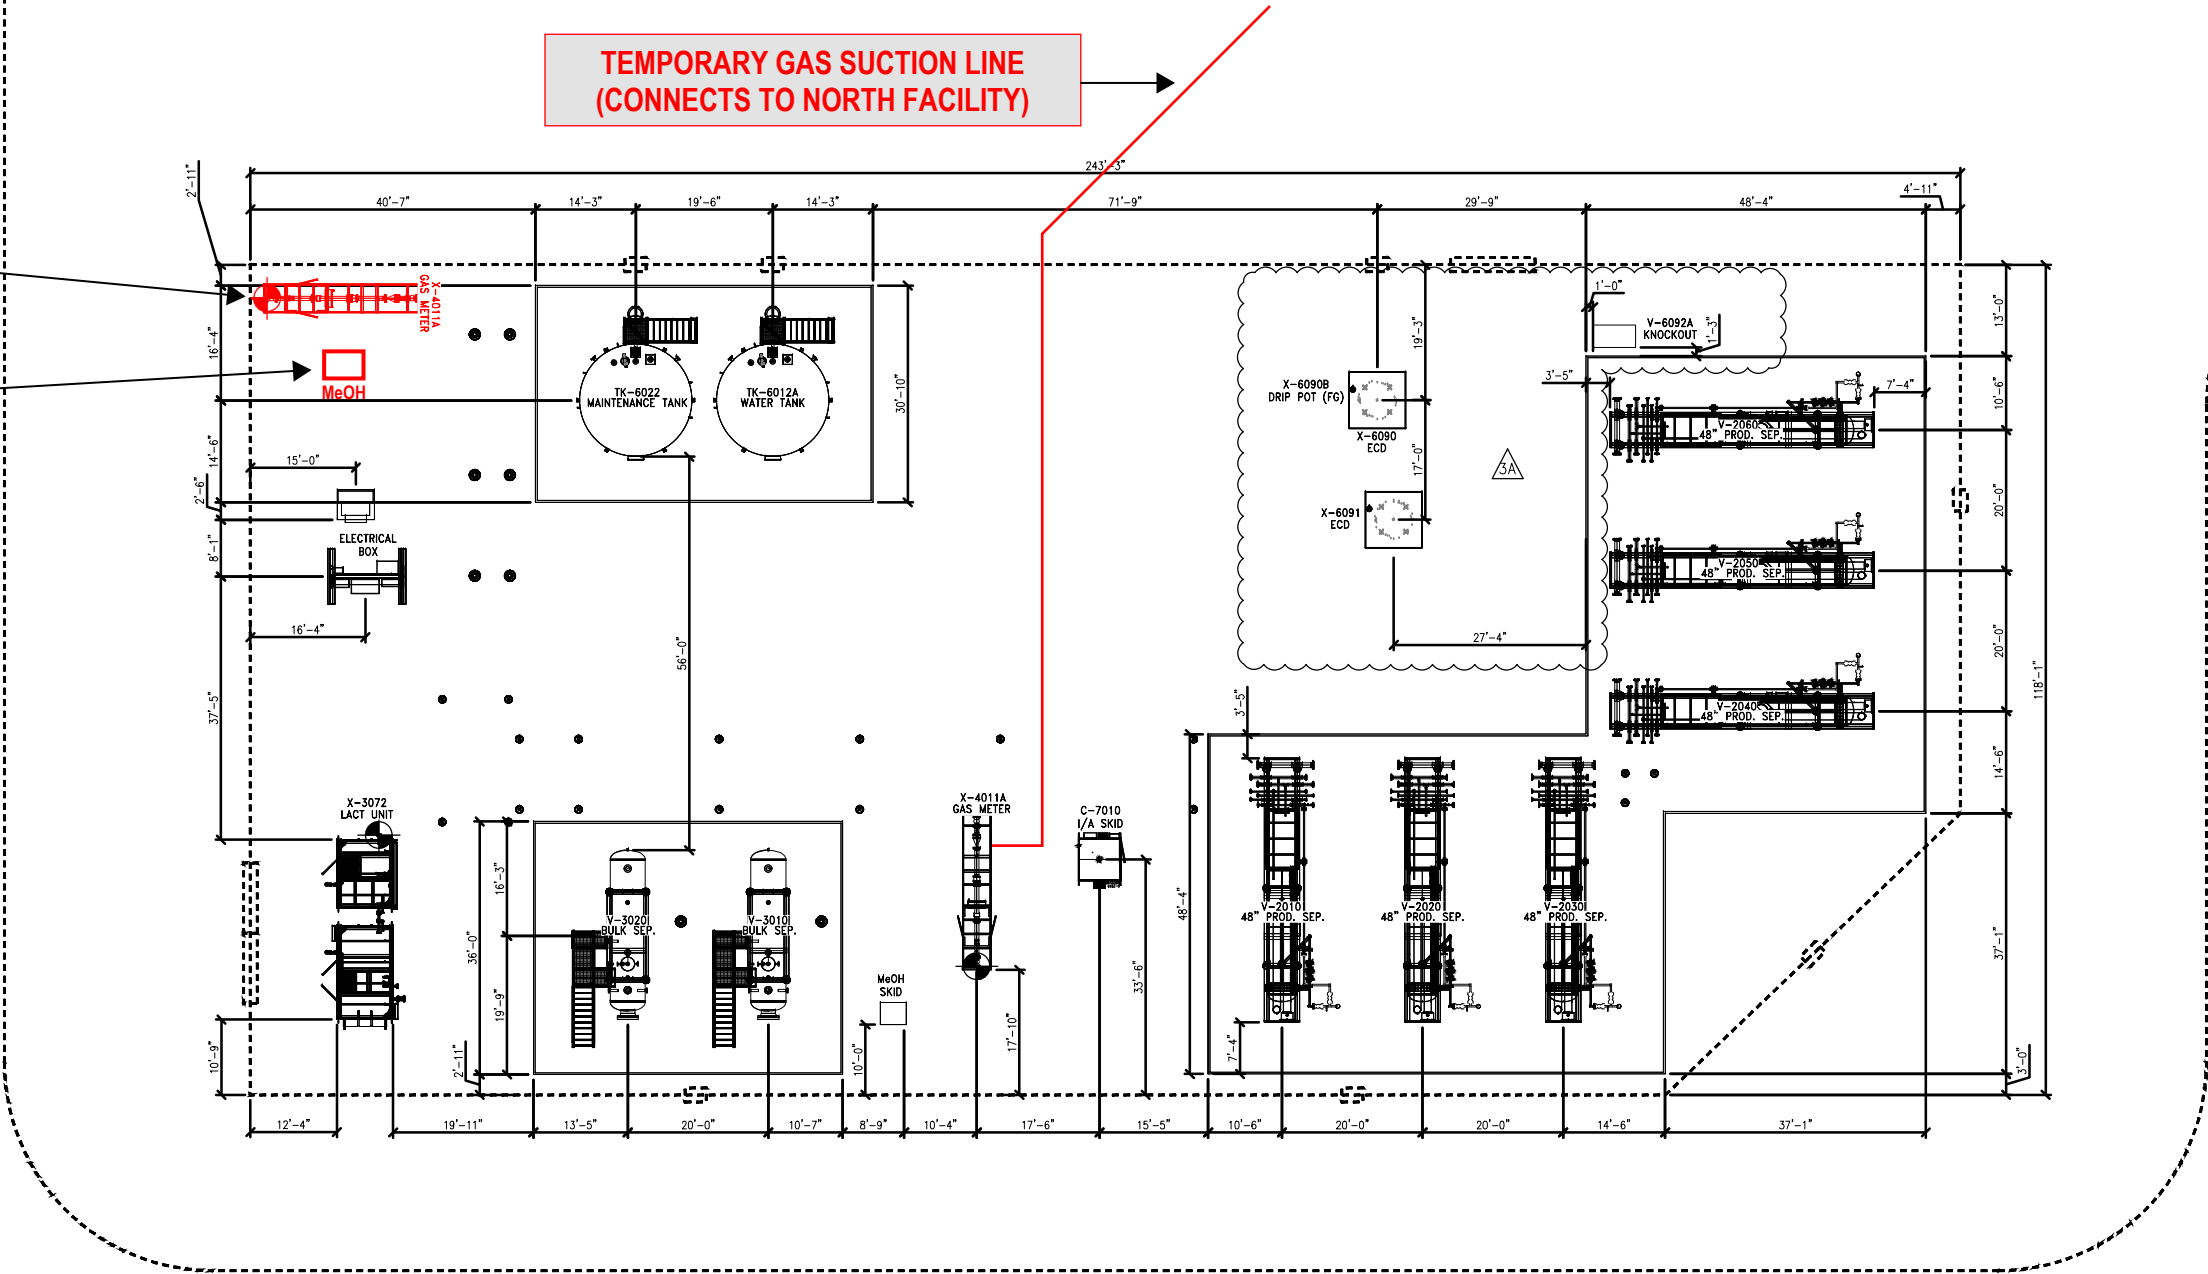

EQUIPMENT LOCATION SCHEDULE

| EQUIPMENT TAG/NAME                | NORTHING         | EASTING           | EQUIPMENT BEARING ELEVATION |
|-----------------------------------|------------------|-------------------|-----------------------------|
| X-3072/73 LACT DISCHARGE NOZZLE   | 1265453'-1.5235" | 3232438'-11.3350" | 4937'-10.6240"              |
| X-4011 GAS METER DISCHARGE NOZZLE | 1265435'-5.3875" | 3232524'-2.5923"  | 4939'-6.8815"               |

NOTES:

1. AGP CONSTRUCTION

REFERENCE DRAWINGS

REVISIONS

| DWG. NO. | TITLE | NO. | DESCRIPTION                     | BY  | CHK. | DATE     | DATE | DATE     |
|----------|-------|-----|---------------------------------|-----|------|----------|------|----------|
|          |       | 1   | ISSUED FOR REVIEW (MOC 22708)   | JTK |      | 06/27/20 | BTJ  | 09/02/20 |
|          |       | 2   | ISSUED - REAL WORLD COORDINATES | RWG |      | 10/16/18 |      | JTK      |
|          |       | 3   | REVISED FOR CONSTRUCTION        | RWG |      | 9/11/18  |      | JTK      |
|          |       | 4   | REVISED FOR CONSTRUCTION        | MRW |      | 02/09/18 |      | JTK      |
|          |       | 5   | ISSUED FOR CONSTRUCTION         | MRW |      | 12/01/17 |      | JTK      |



ROBIN 9-6HZ SOUTH FACILITY

PLOT PLAN  
PRODUCTION FACILITIES  
W/ CONSTRUCTION DIMENSIONS

|                                  |                        |                  |
|----------------------------------|------------------------|------------------|
| DRAWN BY: RWG                    | CREATION DATE: 7/17/17 | A/E No.: 2       |
| APPROVED: JTK                    | APPR. DATE: 7/17/17    |                  |
| DWG. No.: X22111-STOR-02-PP-2030 |                        | SHEET No. 1 OF 1 |
| SCALE: NONE                      |                        |                  |

FILE LOCATION: L:\SharedData\Denver\Rockies\Y22111-STOR-02-ROBIN 16-9 PAD\2. SITE PLAN - GA's\X22111-STOR-02-PP-2030.dwg

LAST SAVED: 8/28/2020 BY: Jaska Uchijima

PLOT STYLE: ----