

State of Colo.
Oil & Gas Cons. Comm.
1313 Sherman St., Rm. 720
Denver, Colorado 80202

78-646

R. 68




RESTAKE

RECEIVED

OCT 19 1978

COLC. OIL & GAS CONS. COMM.

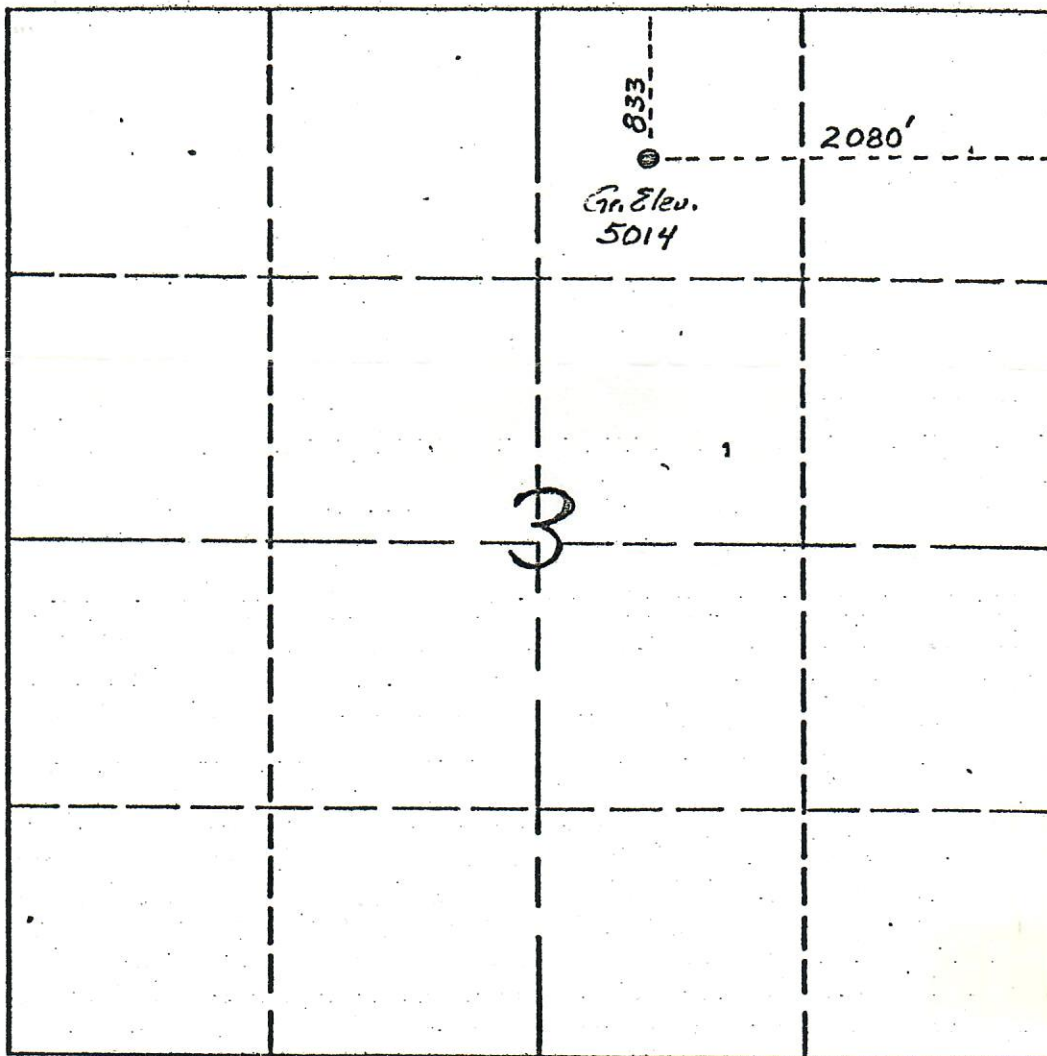

SCALE: 1"=1000



00041527

SAGE ENGINEERS, INC. of FORT LUPTON, COLORADO
has in accordance with a request from *Bob Coldiron*
for **AMOCO PRODUCTION CO.**

determined the location of *Futura Horse Village 413 #3*
to be **833 FNL, 2080 FEL Sec 3, T1N, R68W, Weld Co., Colo.**

I do hereby certify that this plat is a
true and correct representation of a
survey made under my direct supervision.

DATE: 9-21-78

SIGNED: Gail A. Bagley
LICENSED LAND SURVEYER NO. 12294
STATE OF COLORADO