

LOCATION: SE1/4 OF SW1/4 OF SEC. 7, T.1N., R.68W. (874 SSL, 2093 WSL)

Ground Elevation: 4993

Number of Acres: 40

AQUIFER	ELEVATION		NET SAND	DEPTH TO		ANNUAL APPROP A-F	STATUS
	BOT.	TOP		BOT.	TOP		
UPPER DAWSON	----	----	----	----	----	----	---
LOWER DAWSON	----	----	----	----	----	----	---
DENVER	----	----	----	----	----	----	---
UPPER ARAPAHOE	----	----	----	----	----	----	---
LOWER ARAPAHOE	----	----	----	----	----	----	---
LARAMIE-FOX HILLS	4635	4950	171.8	358	43	10.31 E	NNT

note: E indicates location is at aquifer boundary and values may be more approximate.
Data for the LARAMIE FOX-HILLS may be missing or approximate and should be checked against DENVER BASIN ATLAS NO. 4
want to do another (Y/N) (press P to print)

Must Set SFG 50' Below Fox Hills.




00051123

OIL AND GAS WELL/WATER WELL

BASE PLAT

O = WATER WELL

SN = SHANNON

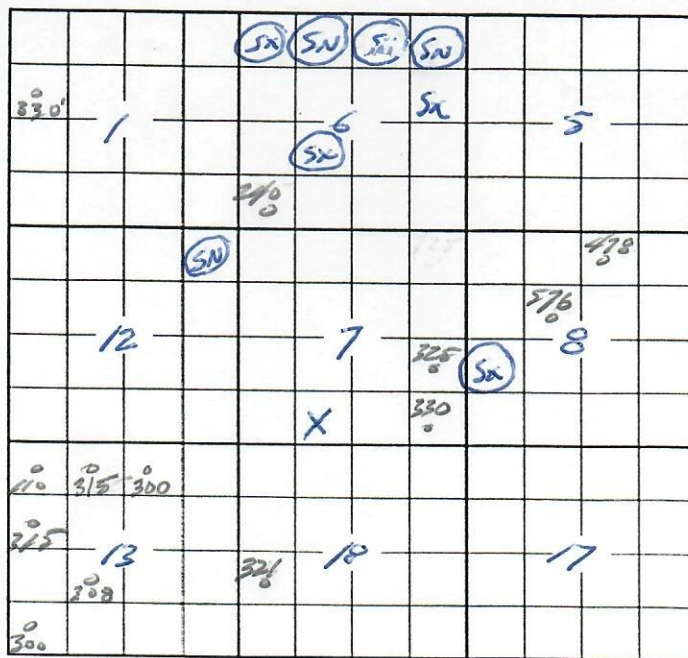

INDUCTION - SELF

FOLD HERE

The well name, location and borehole reference data were furnished by the customer

All interpretations are opinions based on inferences from electrical or other measurements, and we cannot guarantee the accuracy or correctness of any interpretations, and we shall not except in the case of gross or willful negligence on our part be liable or responsible for any loss, costs, damages or expenses incurred or sustained by anyone resulting from any interpretation made by any of our officers, agents or employees. These interpretations are also subject to our General Terms and Conditions as set out in our current Price Schedule.

FILE

8

BEST COPY
AVAILABLE

Coping

		ILD (OHMM)	0.0	50.00
		SFLA(OHMM)	0.0	10.00
		SFLA(OHMM)	0.0	50.00
		CILD(MMHD)	2000.	0.0
SP (MV)				
-160.0	40.00			

FILE

8

BEST COPY
AVAILABLE

