



00047896

CERTIFICATE OF SURVEY
for
Patrick A. Doheny
Washington County, Colorado


RECEIVED

JAN 14 1971

COLO. OIL & GAS CONS. COMM.

SCANNED

T2N R53W 6PM

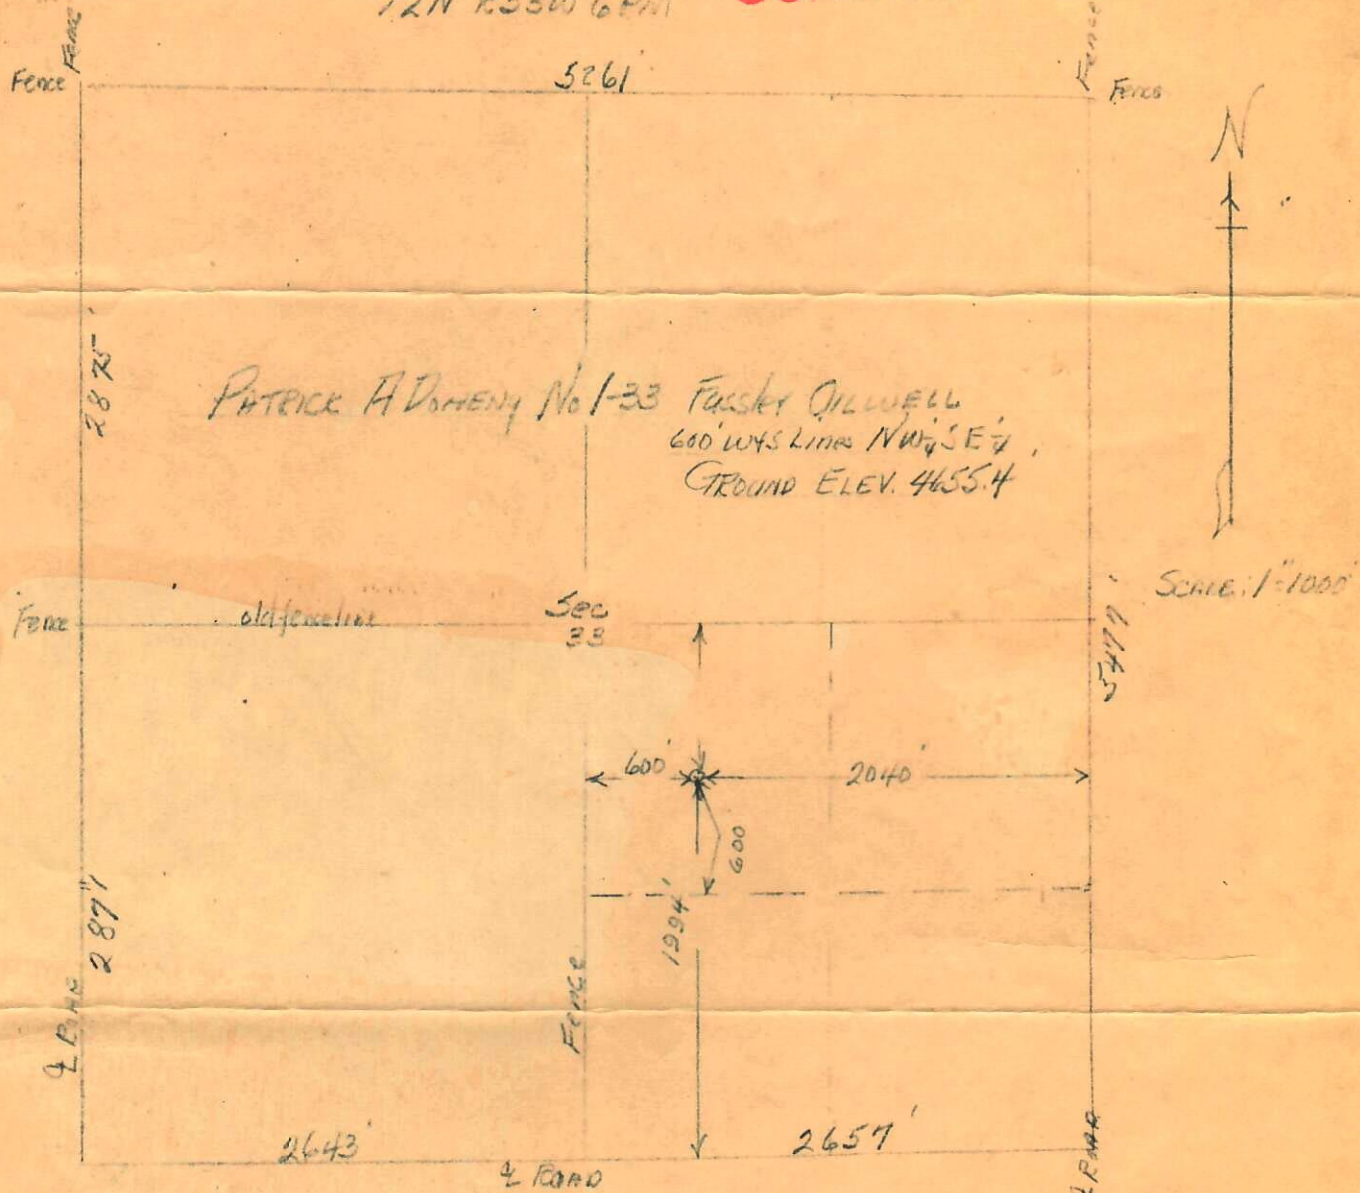

I hereby certify that the above plat is an accurate representation of a correct survey showing the location of Patrick A. Doheny-No. 1-33 Fassler Oilwell 600 feet from west and south lines NW 1/4 SE 1/4 Sec. 33 T2N R53W 6PM. The elevation of the ground at the stake is 4655.4 feet above sea level from U.S.C.&G. Bench Mark.

Fort Morgan, Colorado
Jan. 8, 1971

David J. Osborne
Registered Professional Engineer
State of Colorado

71-10