


Operator: KERR-MCGEE OIL AND GAS ONSHORE LP  
Well: BLUE CHIP 22-9HZ  
API#: 0512351939  
County, State: WELD, COLORADO  
Lat/Long: 40.388034 / -104.880307  
Location: 5N 67W 22 FNL 1598 FWL 2179  
Directions: CR 56 & HWY 257, W 6/10, S 2/10, E INTO

Spud: 1/23/2023  
Date TD Reached: 5/12/2023  
GL: 5036  
TMD: 23078  
PBMD: 23017

Date: 11/13/2024  
KB: 5065  
TVD: 7162  
PBTVD: 7162

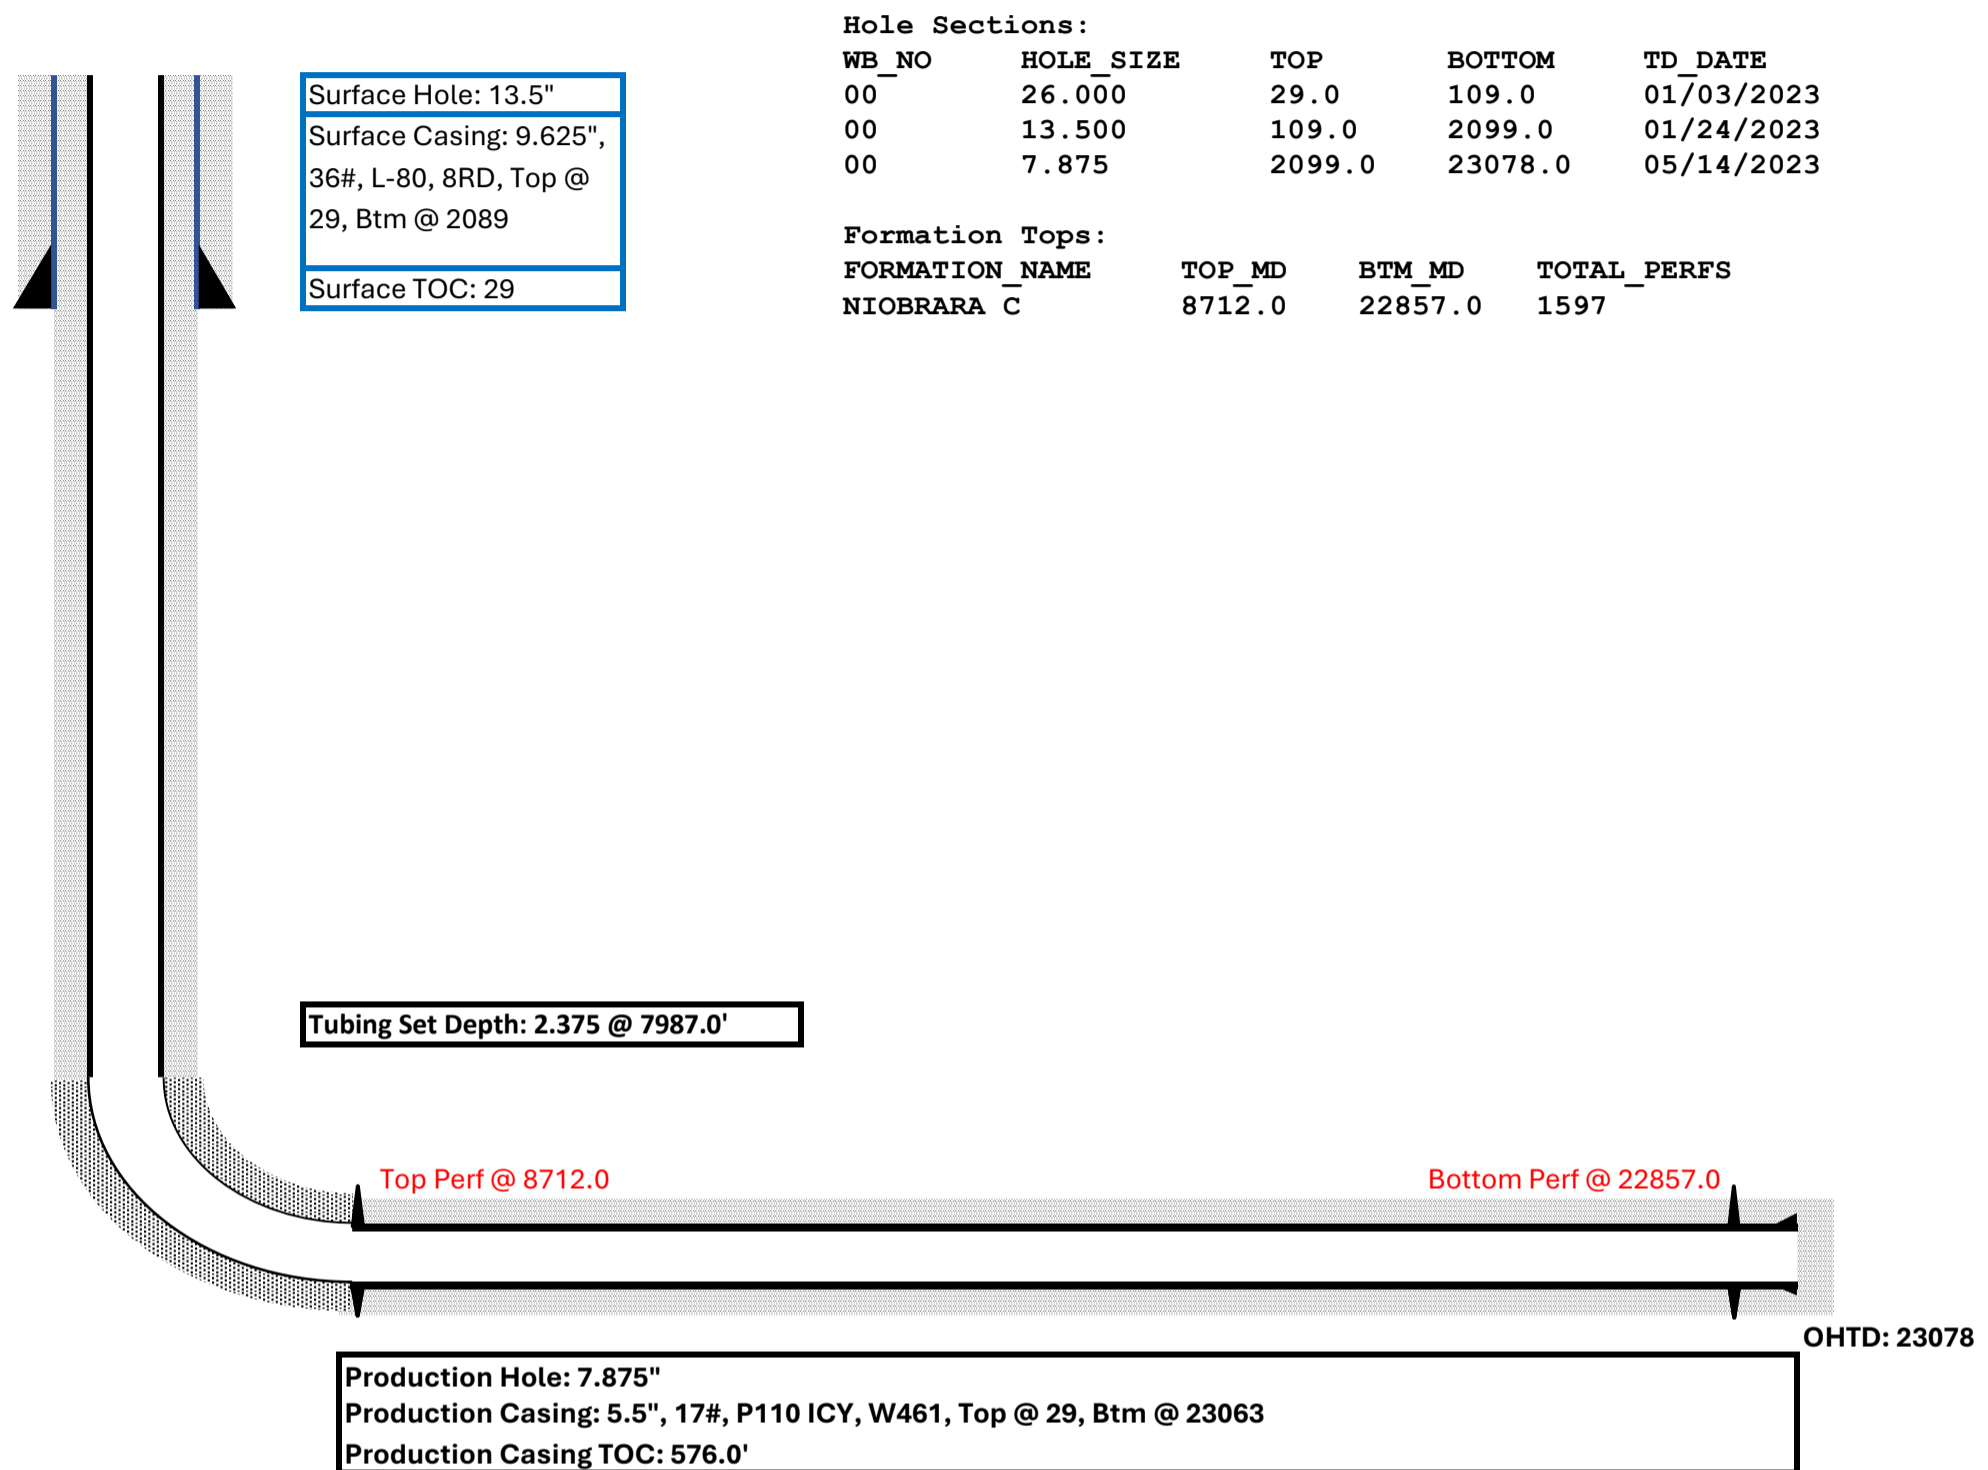

Cement Jobs:

ASSEMBLY_NAME	JOB_TYPE	SACKS_USED	FLUID_TYPE	SLURRY_DESC	TOP	BTM	CBL	LOG_TOC_MD
SURFACE CASING	PRIMARY	0.0	FRESH WATER	WATER	29.0	2050.0	No	
SURFACE CASING	PRIMARY	896.0	LEAD CEMENT	NEAT	29.0	2089.0	No	
SURFACE CASING	PRIMARY	0.0	FRESH WATER	WATER	29.0	29.0	No	
PRODUCTION CASING	PRIMARY		MUDPUSH	Tuned Spacer 3	29.0	710.0	Yes	576.0
PRODUCTION CASING	PRIMARY	1560.0	TAIL CEMENT	Tail Slurry	8700.0	23078.0	Yes	576.0
PRODUCTION CASING	PRIMARY	850.0	LEAD CEMENT	PressureNET	710.0	8700.0	Yes	576.0
PRODUCTION CASING	PRIMARY		FRESH WATER	Fresh Water	29.0	23021.0	Yes	576.0