

Flowline Abandonment Type:

Abandon in Place due to common trench with active flowline.

**Flowlines**


- Abandoned
- Active
- Out of Service
- Pre-commissioned
- Removed
- Turned into Air Line
- Area of Conflict (Proposed Abandon-in-Place Area)
- X Proposed Soil Sample Location
- Field Screening Location

**Wells**

- Active
- Abandoned Location
- Dry & Abandoned
- ✱ Plugged & Abandoned
- ✱ Producing
- ✱ Shut-In
- Temporarily Abandoned

**Third-Party Pipelines**

- — —
- — —
- — —
- — —
- NWI Wetlands

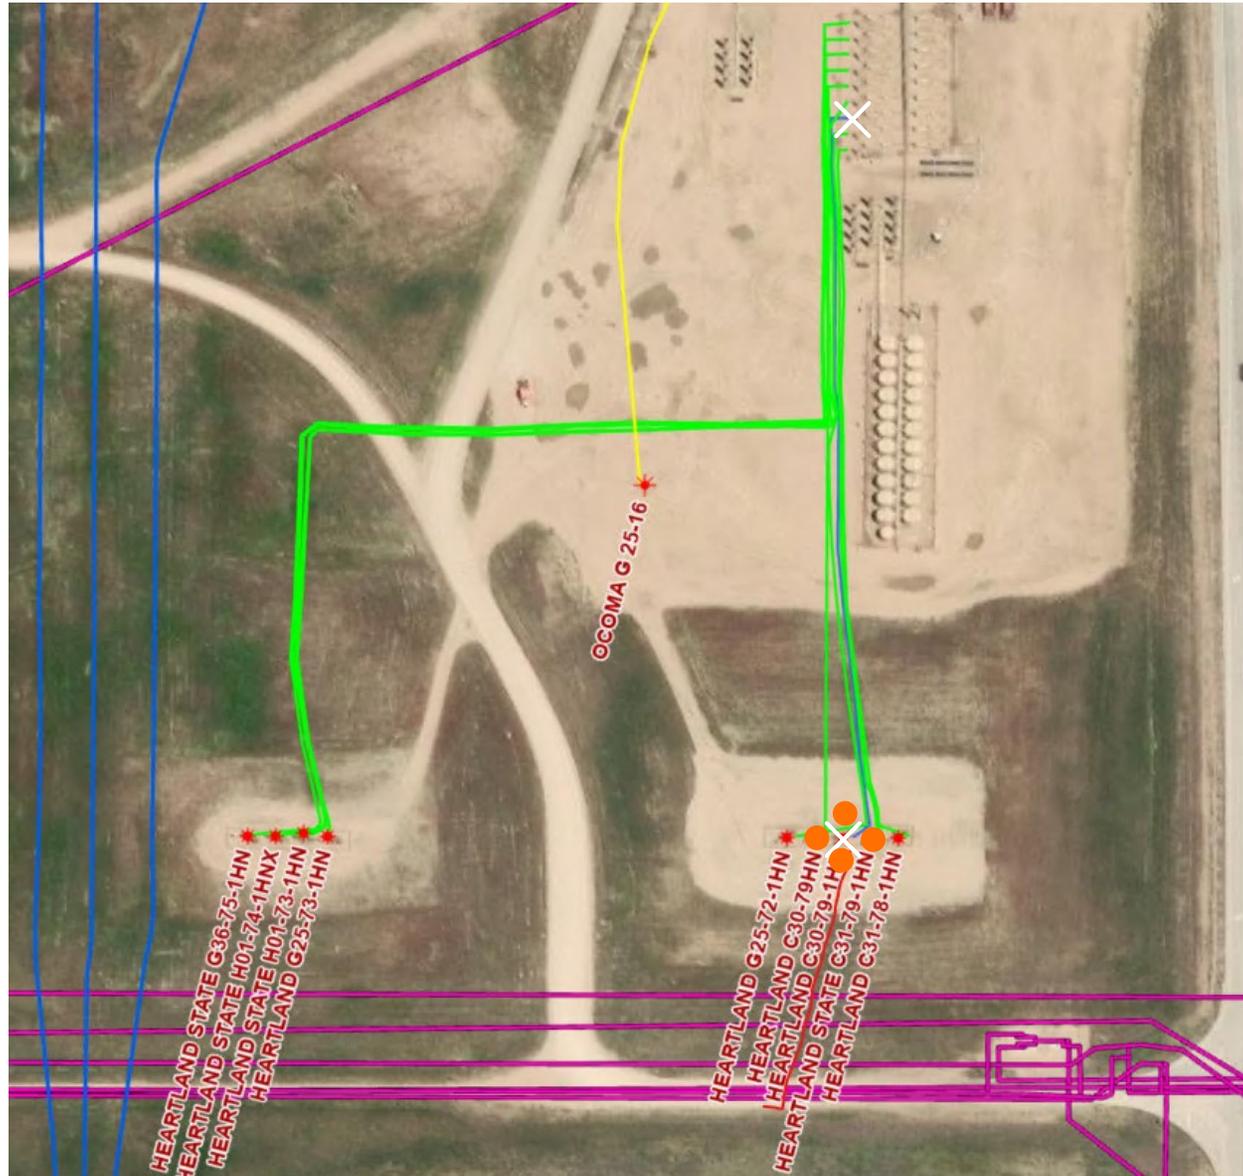

Well Latitude/Longitude: 40.276743/-104.603499  
 Flowline Length (ft): 791

Flowline Point A Latitude/Longitude: 40.27674624/-104.6034681  
 Flowline Point B Latitude/Longitude: 40.27885956/-104.6034889

Created By: Henry Lawrence  
 Date: 12/05/2024

