


Schematic - Proposed vs Current_Form6

Well Name: UPRR #12

API/UWI 05-123-05436	Surface Legal Location SENE Section 1 T7N R67W	Field Name Black Hollow	License #	State/Province Colorado	Well Configuration Type Vertical
Original KB Elevation (ft) 5,160.00	Ground Elevation (ft) 5,146.00	Spud Date	Rig Release Date	PBTD (All) (ftKB)	Total Depth All (TVD) (ftKB)
Directions To Well					

Vertical, Original Hole, 1/12/2025 9:55:50 PM

Vertical schematic (proposed)

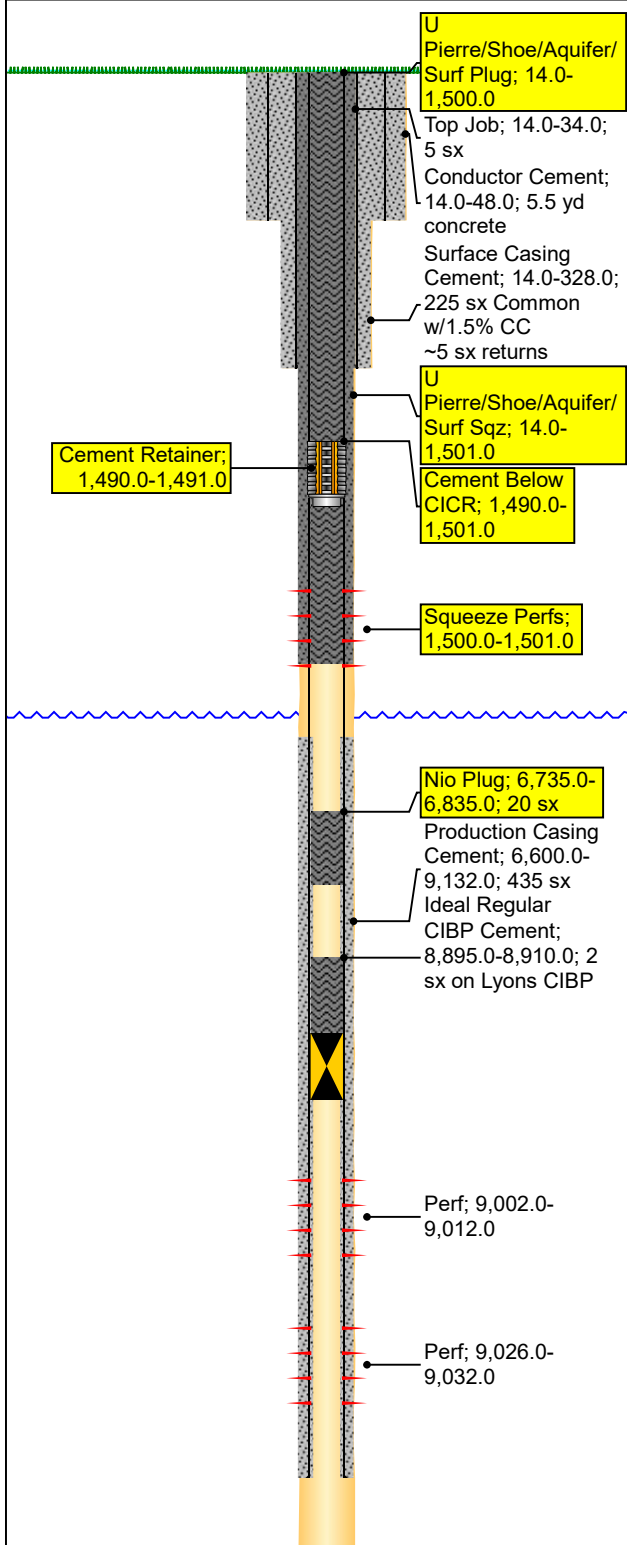

Vertical schematic (actual)

