


Field Observations Map

Location Name: McHale, Hazel 1

Location ID: 317719

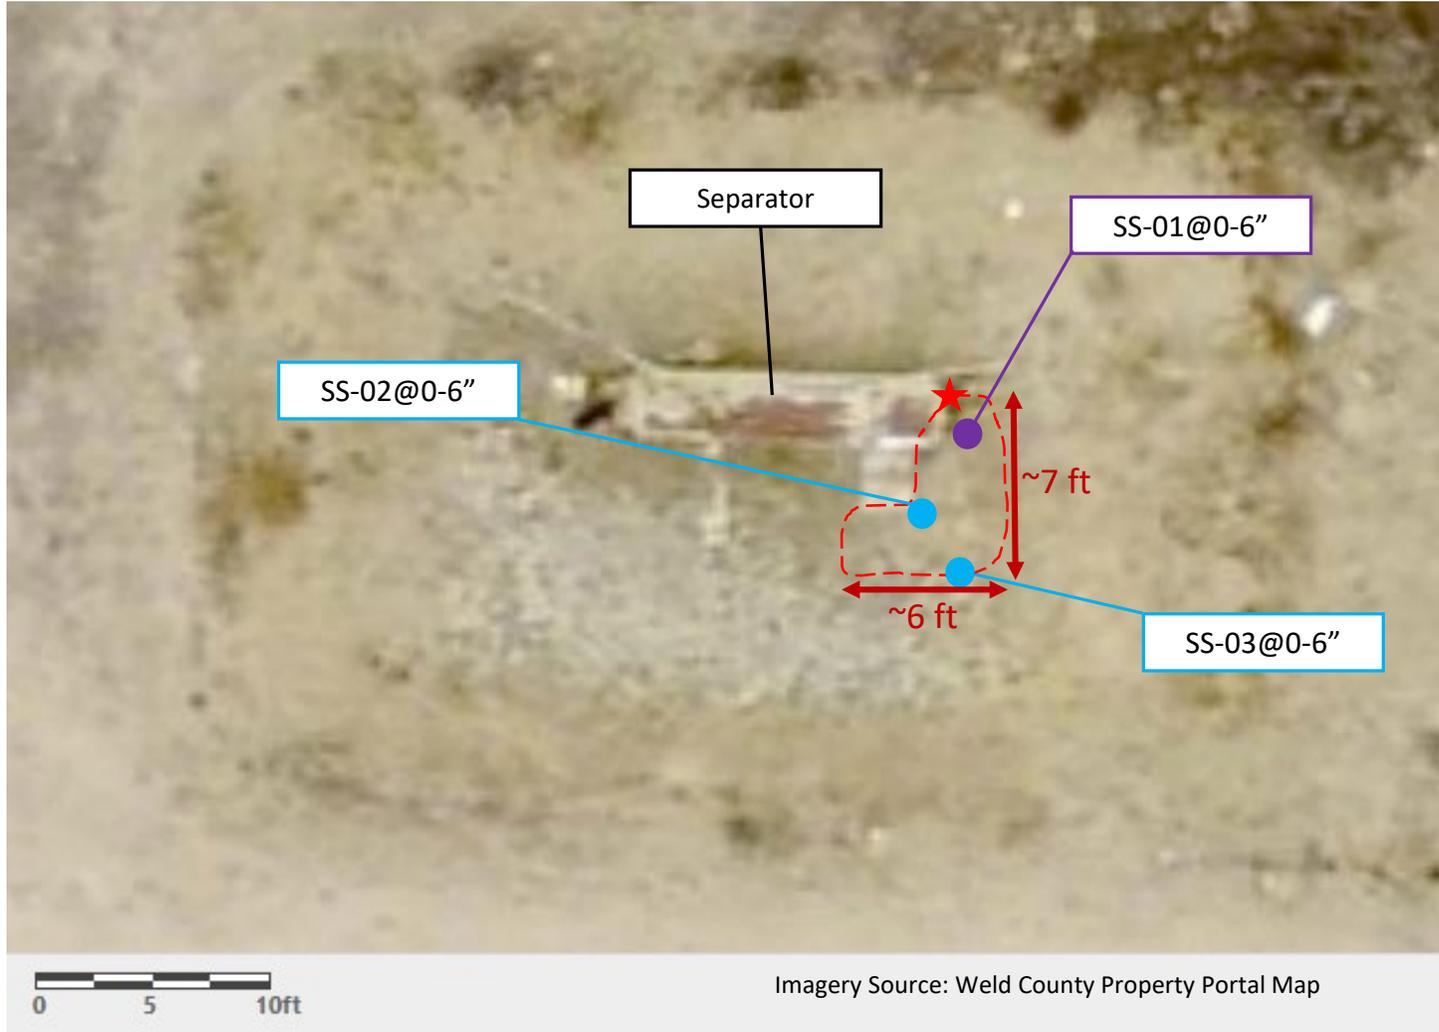

Legend

- ★ Leaking Equipment/Spill Location
- Soil Sample Locations – Lab Analyzed
- Soil Sample Locations – Field Screened
- ↔ ~5 ft Approximate Aerial Extents of Visibly Stained Soil (feet)
Inferred from Complaint (Document Number 404048198)