

OIL & GA  
CONSERVATION COMMISSION




00047797

CERTIFICATE OF SURVEY  
for  
Patrick A. Doheny  
Washington County, Colorado

Conservation Commission

SCANNED

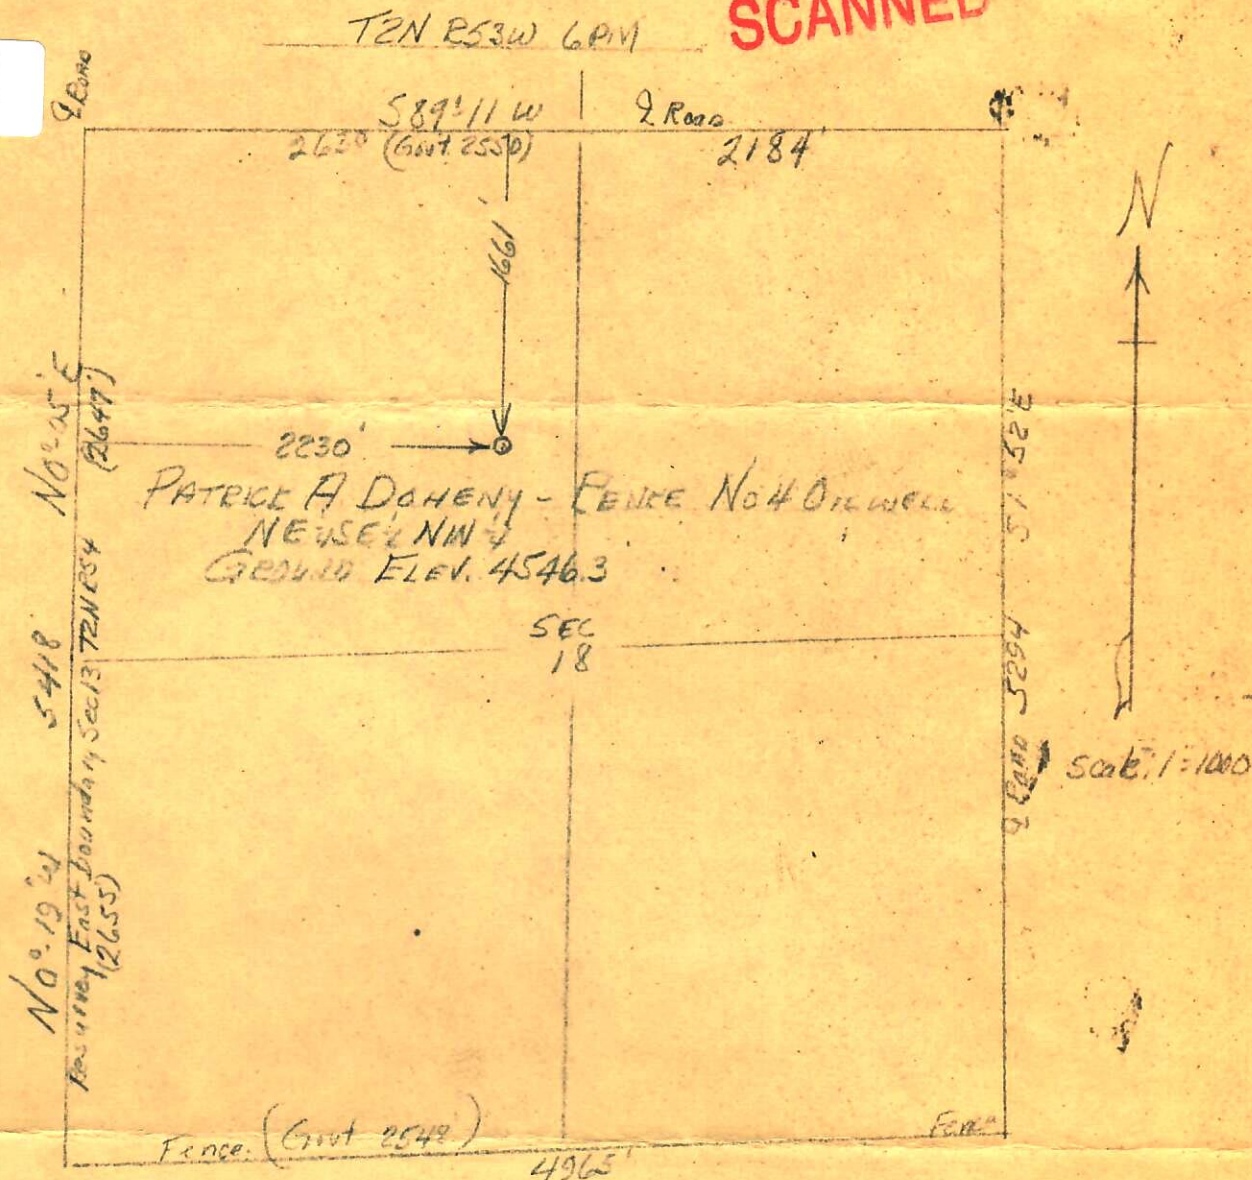

I hereby certify that the above plat is an accurate representation of a correct survey showing the location of Patrick A. Doheny - Fence No. 4 Oilwell in NE 1/4 Sec. 18 T2N R53W 6PM. The elevation of the ground at the stake is 4546.3 feet above sea level from U.S.C.&G. Bench Mark.

Fort Morgan, Colorado  
April 2, 1963

Registered Professional Engineer  
State of Colorado.