
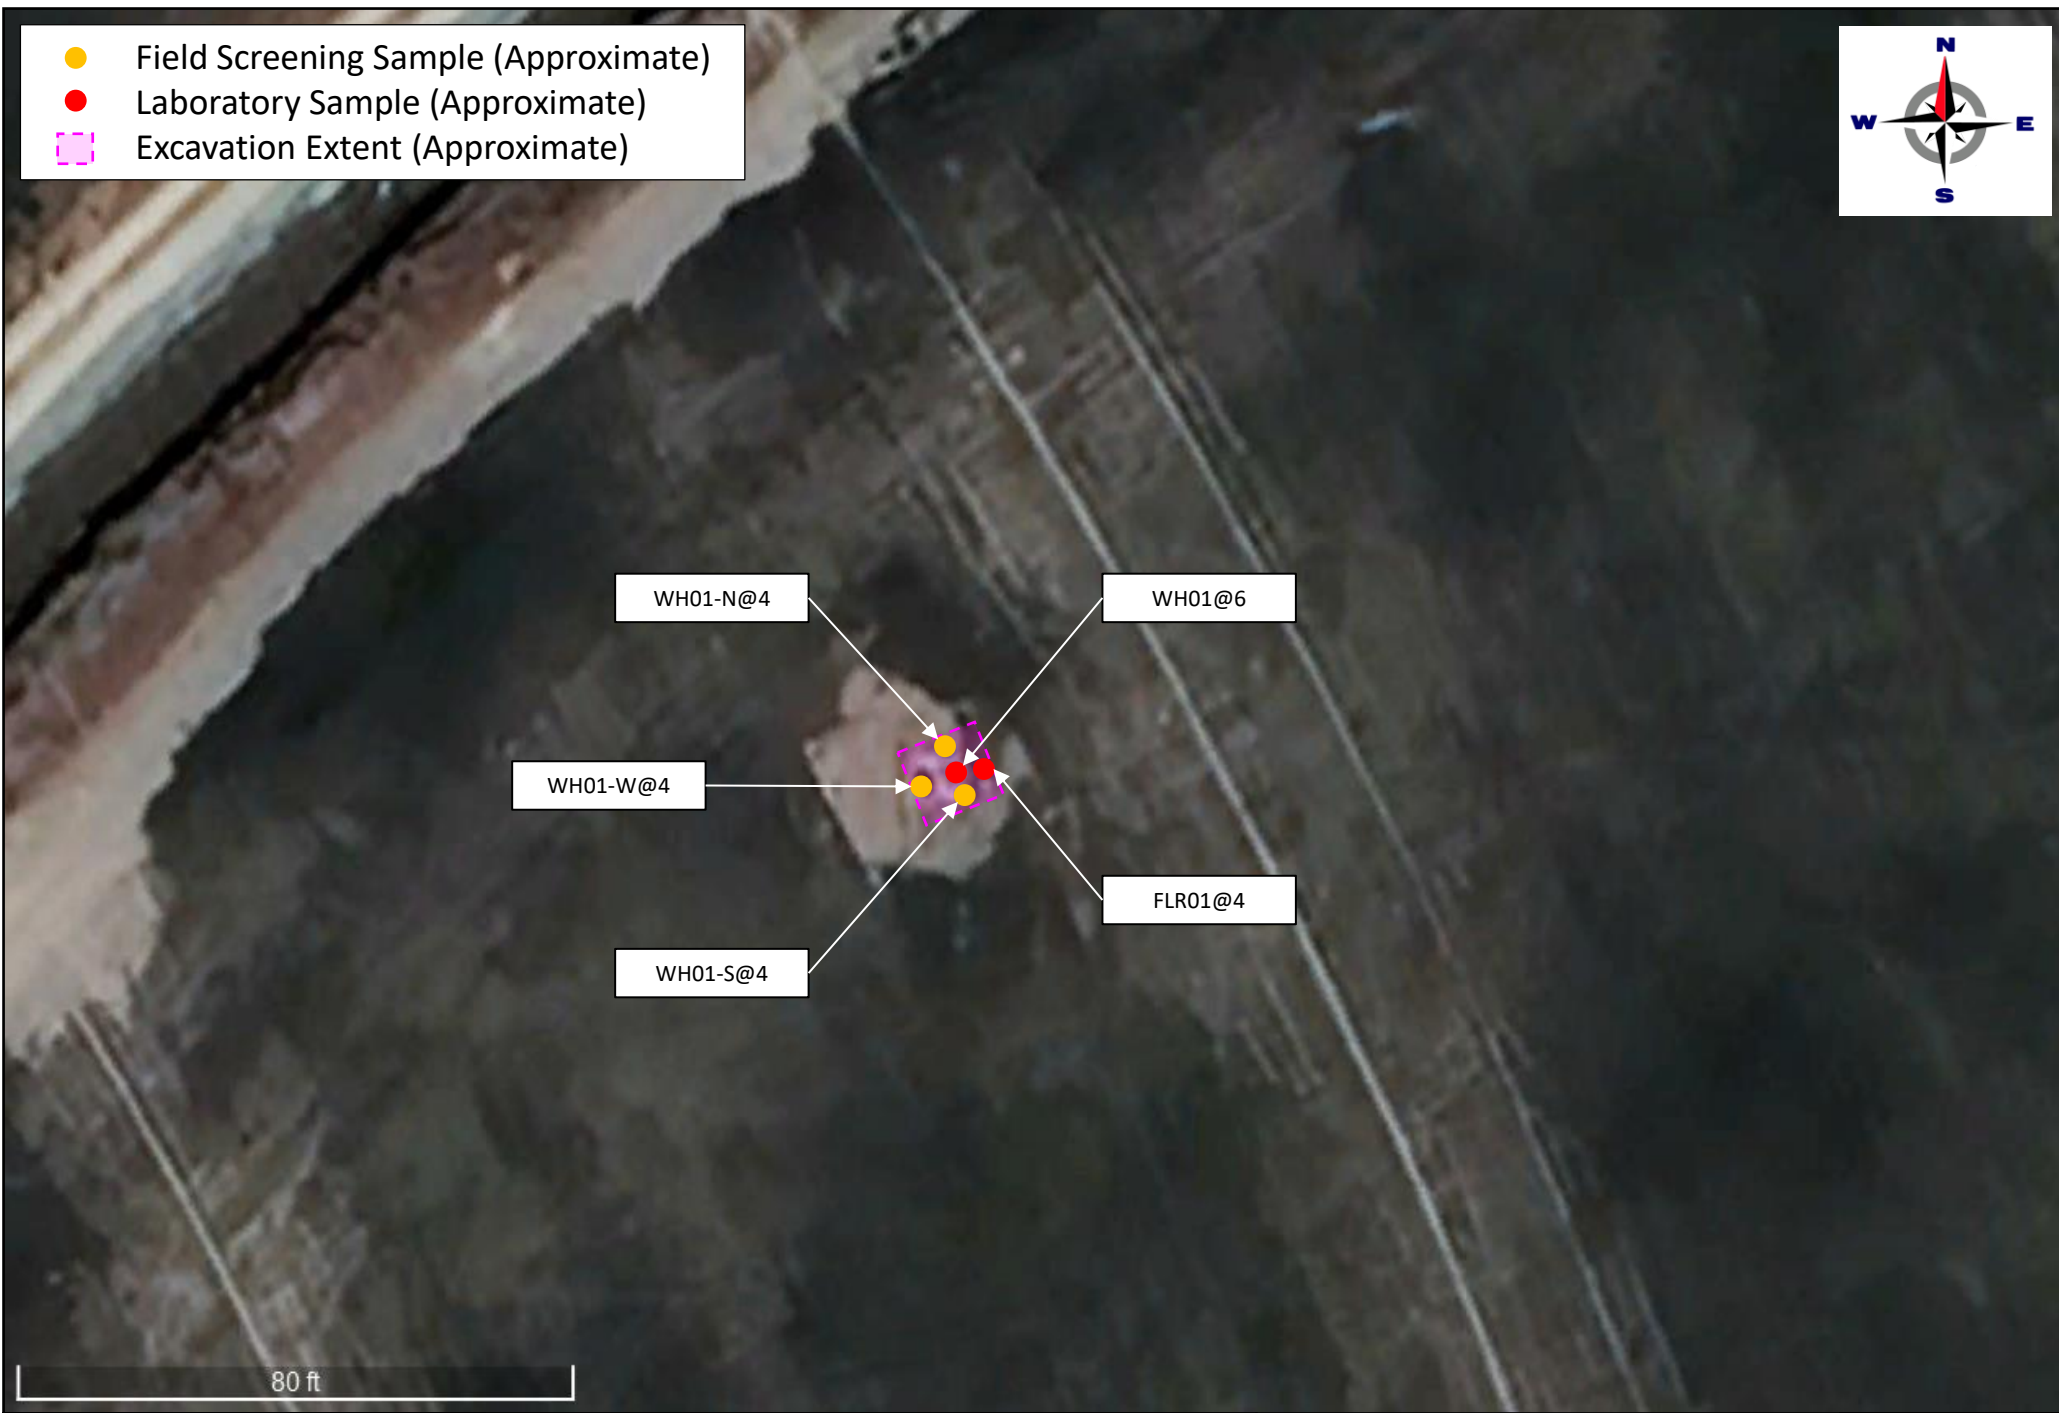



- Field Screening Sample (Approximate)
- Laboratory Sample (Approximate)
- Excavation Extent (Approximate)

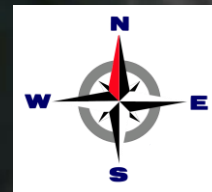

Project No:	Historic Release Location Dr Joe CC06-09 Wellhead NESE Sec. 6 4N63W 6 PM	 1843 Sunlight Dr. Longmont, CO 80504 303.378.4036	FIGURE
Drawn By: LB			2
Date: 11/15/2024			