




FORM F-106



RECEIVED  
MAR 30 1977  
OIL & GAS CONS. COMM.

R. 54W

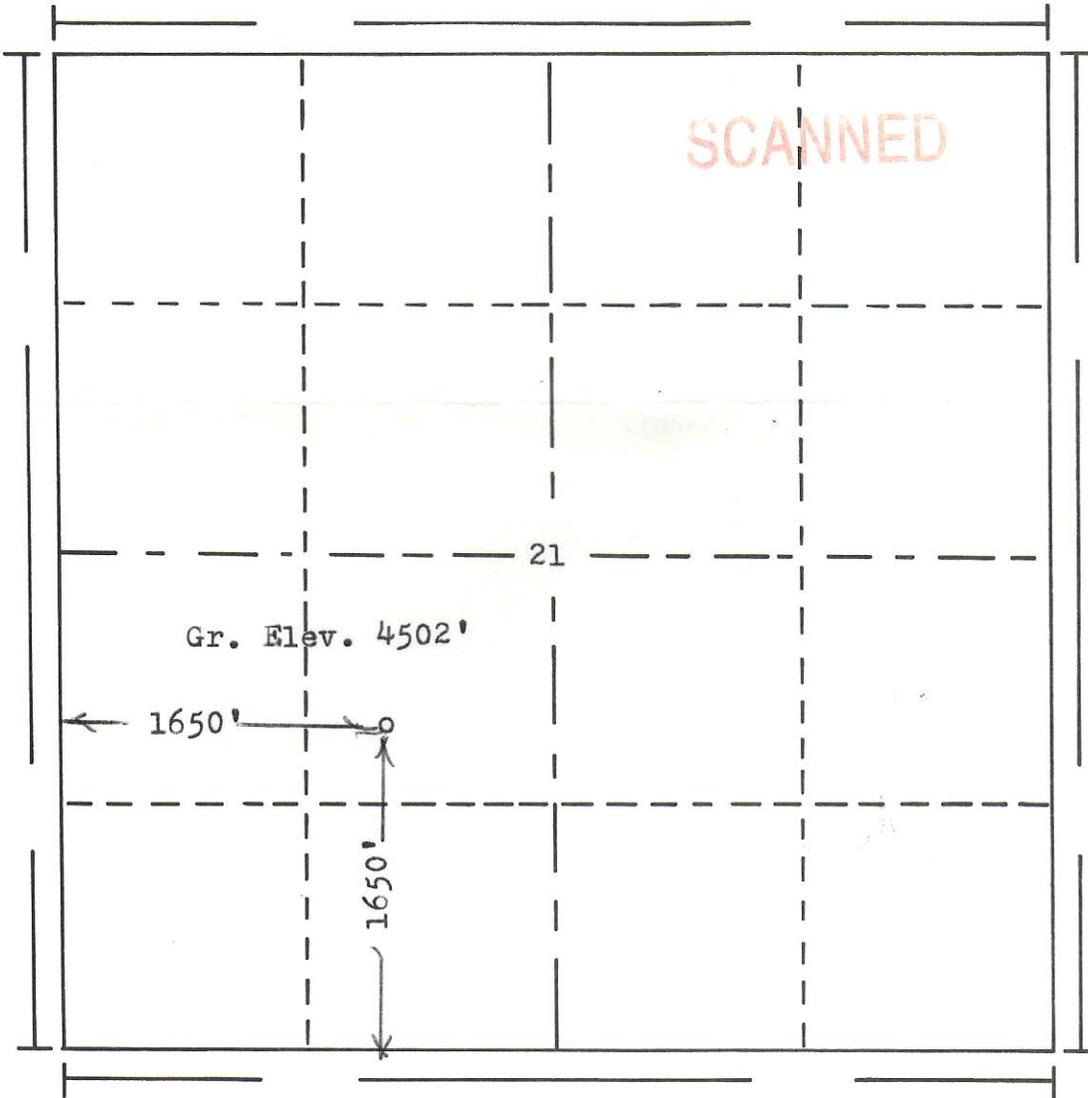

T.  
2  
N

77-248

Scale... 1" = 1000'

**Powers Elevation Company, Inc. of Denver, Colorado**  
has in accordance with a request from Mr. Brown  
for Amarex

determined the location of No. ? ?  
to be CSW NE SW Section 21 Township 2N  
Range 54W of the 6th Principal Meridian  
Washington County, Colorado

I hereby certify that this plat is an  
accurate representation of a correct  
survey showing the location of

Date: 3-24-77

Bruce J. Holloman  
Licensed Land Surveyor No. 2853  
State of Colorado

