


Western Operating Company

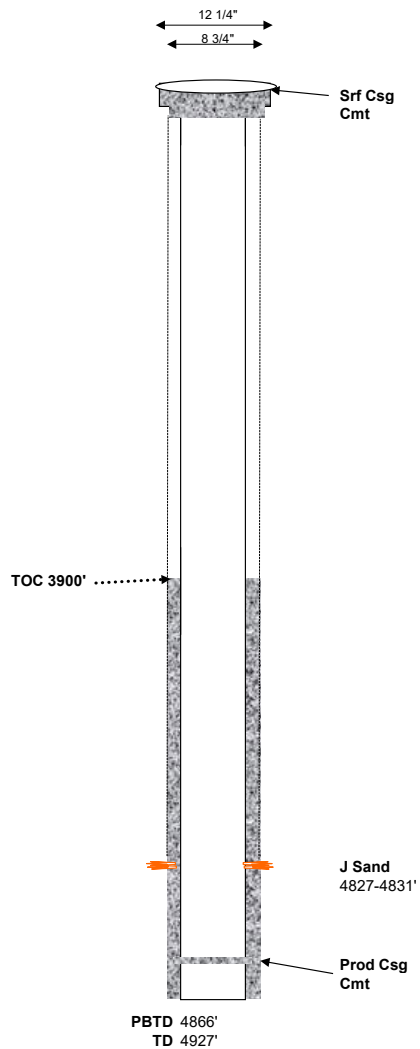

General Well Info			
Well Name:	Xenia West Unit #3-3X	Field:	Xenia West
Diagram Date:	1/22/2025	County:	Washington
Srf Location:	SENE 11 2N54W 6	State:	CO
Spud Date:	12/6/2003	API #:	05-121-10699
GL Elev:	4486'		
Formation Tops			
Zone	Depth	Zone	Depth
Niobrara	3905'		
Fort Hays	4240'		
D Sand	4704'		
J Sand	4790'		

12 1/4" hole, 10 3/4" casing, 40.5# @ 210' KB
120 sx at 210' to surface

Srf Csg 12 1/4" hole, 10 3/4" casing, 40.5# @ 210' KB
Cmt 120 sx at 210' to surface
Prod Csg 8 3/4" hole, 7" casing, 20# @ 4927'
Cmt 135 sx at 3900' - 4927' KB

8 3/4" hole, 7" casing, 20# @ 4927'
135 sx at 3900' - 4927' KB