



Site Diagram: Site Investigation

QB Energy Operating, LLC
 P27 595
 (N. Parachute/EF P27 595)
 ECMC Location ID: 335806
 Garfield County
 SESE Sec. 27 T5S-R95W 6

-  Soil Sample
-  Excavation Extent 01/16/2025
-  Composite Aliquot
-  Soil Stockpile 01/16/2025

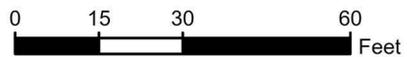

Map Created by: Alex Slorby 01/20/2025

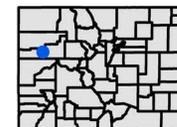

 **CONFLUENCE**
COMPLIANCE COMPANIES

Spatial data was collected using a handheld GPS unit with submeter accuracy. Illustration discrepancies may be present in this diagram due to the inherent limitations of data accuracy for both project data and the underlying aerial imagery. The position of illustrated data may have been manually adjusted to align with the aerial imagery in a manner more representative of field conditions for presentation purposes only.