

Final Reclamation and Stormwater Inspection

Date: 02/06/2025

Operator: EXTRACTION OIL & GAS INC - 10459

Location ID: 448568

Inspection Document #: 718700047

Weld County, CO



COLORADO
Energy & Carbon Management
Commission
Department of Natural Resources

Inspection Photos
Location Name: Bliss 10-33 TB
Location ID: 448568

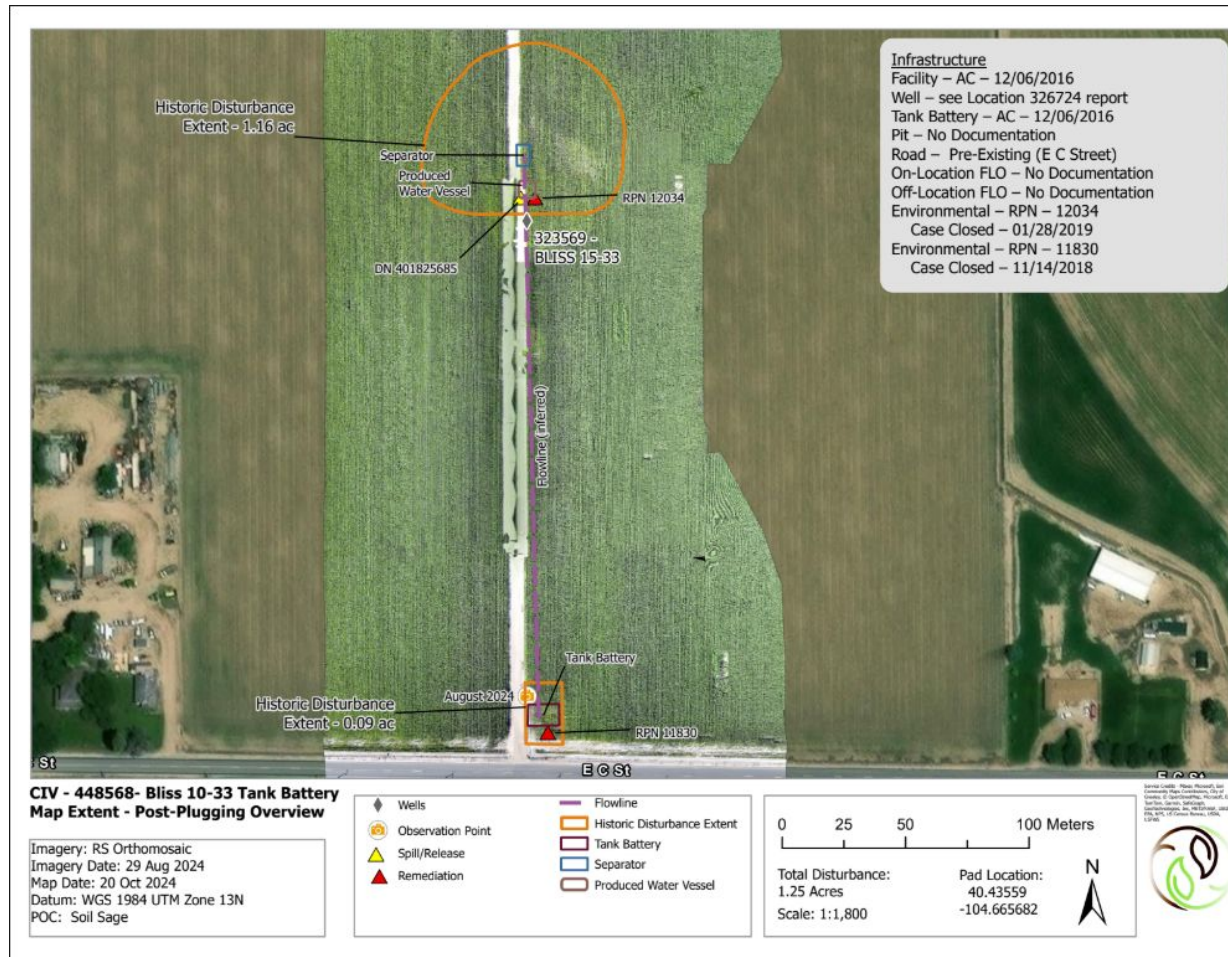


Photo 1. Orthomosaic imagery taken from the drone closure report (Page 12), illustrating the tank battery extent in orange outline.

Drone Photo Height

120 feet

Cardinal directional photos of the site. Reference overview map.



Photo 2. Drone aerial imagery of the former tank battery (Page 13). The former tank battery location (outlined in red by ECMC) does not appear to be reflective of the adjacent reference areas (outlined in orange by ECMC).