

# Final Reclamation and Stormwater Inspection

Date: 02/06/2025

Operator: PDC ENERGY INC - 69175

Location ID: 328533



Inspection Document #: 718700052

Weld County, CO



**COLORADO**  
Energy & Carbon Management  
Commission  
Department of Natural Resources

Inspection Photos  
Location Name: White 27-5  
Location ID: 328533

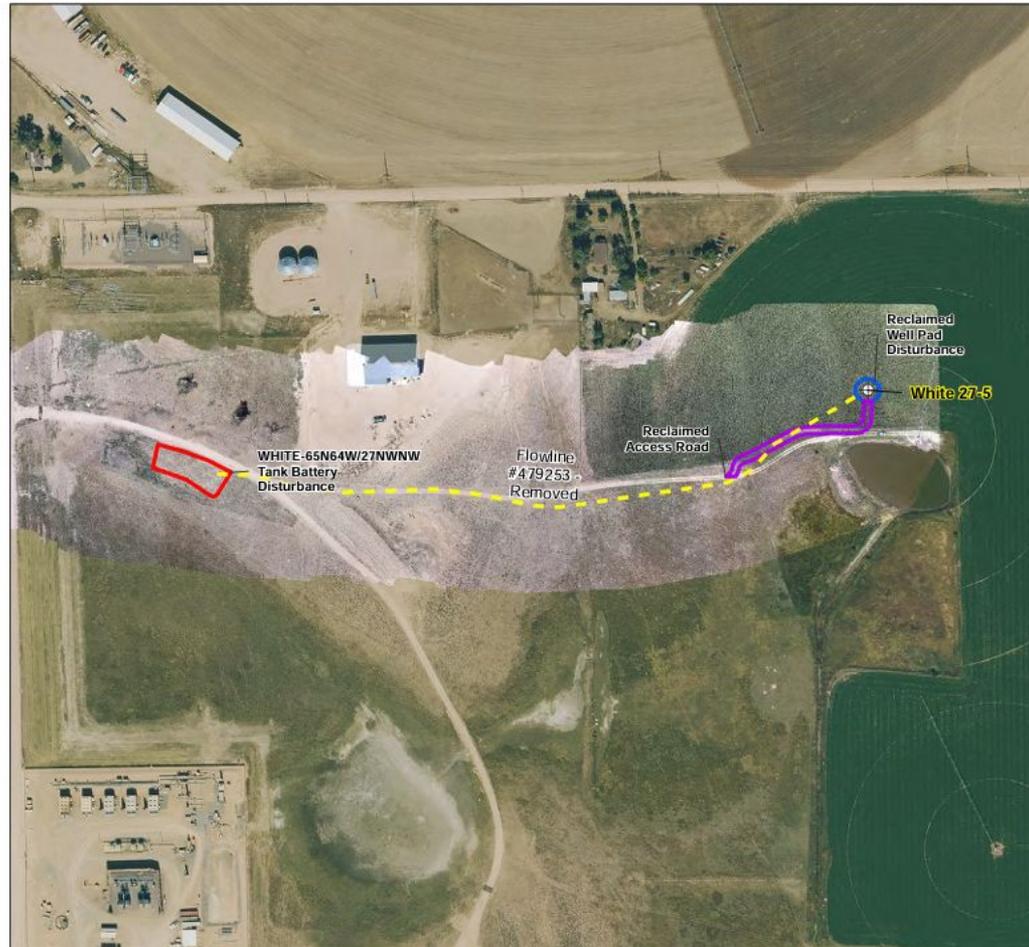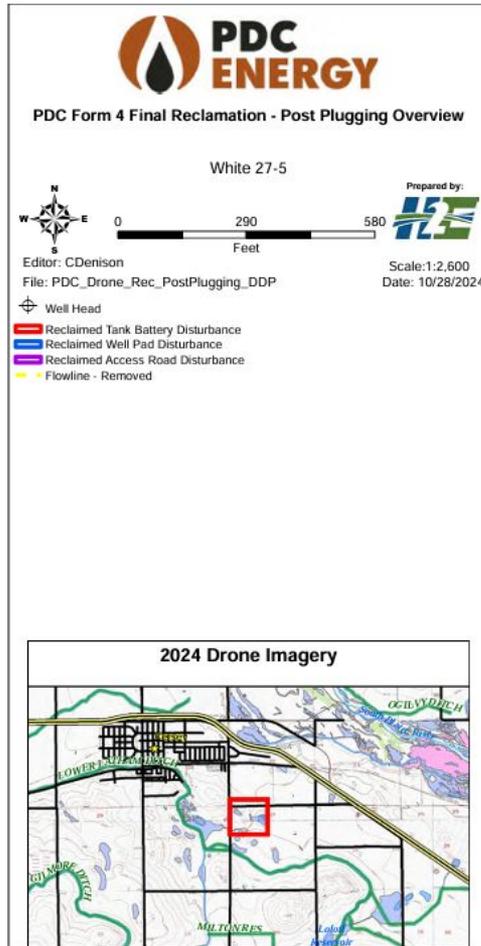

**Photo 1.** Orthomosaic imagery taken from the drone closure report (Page 10). Operator has indicated in the closure report that the purple outline is the former access road.

Inspection Photos  
Location Name: White 27-5  
Location ID: 328533



**Photo 2.** Google Earth aerial imagery (circa 07/2011) illustrating the entire access road (red outline) during active oil and gas operations for Well API 123-16108.

Inspection Photos  
Location Name: White 27-5  
Location ID: 328533



**Photo 3.** Aerial imagery (Earth Explorer, 09/07/1978) illustrating that the access road did not appear to exist prior to the subject Well API 123-16108 being spud (10/16/1992). Red arrow indicates approximate location of Well API 123-16108.