


PLUGGED AND ABANDONED WELL EXHIBIT


UPRR 1 (05-001-05084)

NE SEC. 7
FND. 2-1/2"
ALUM. CAP.
PLS 23899

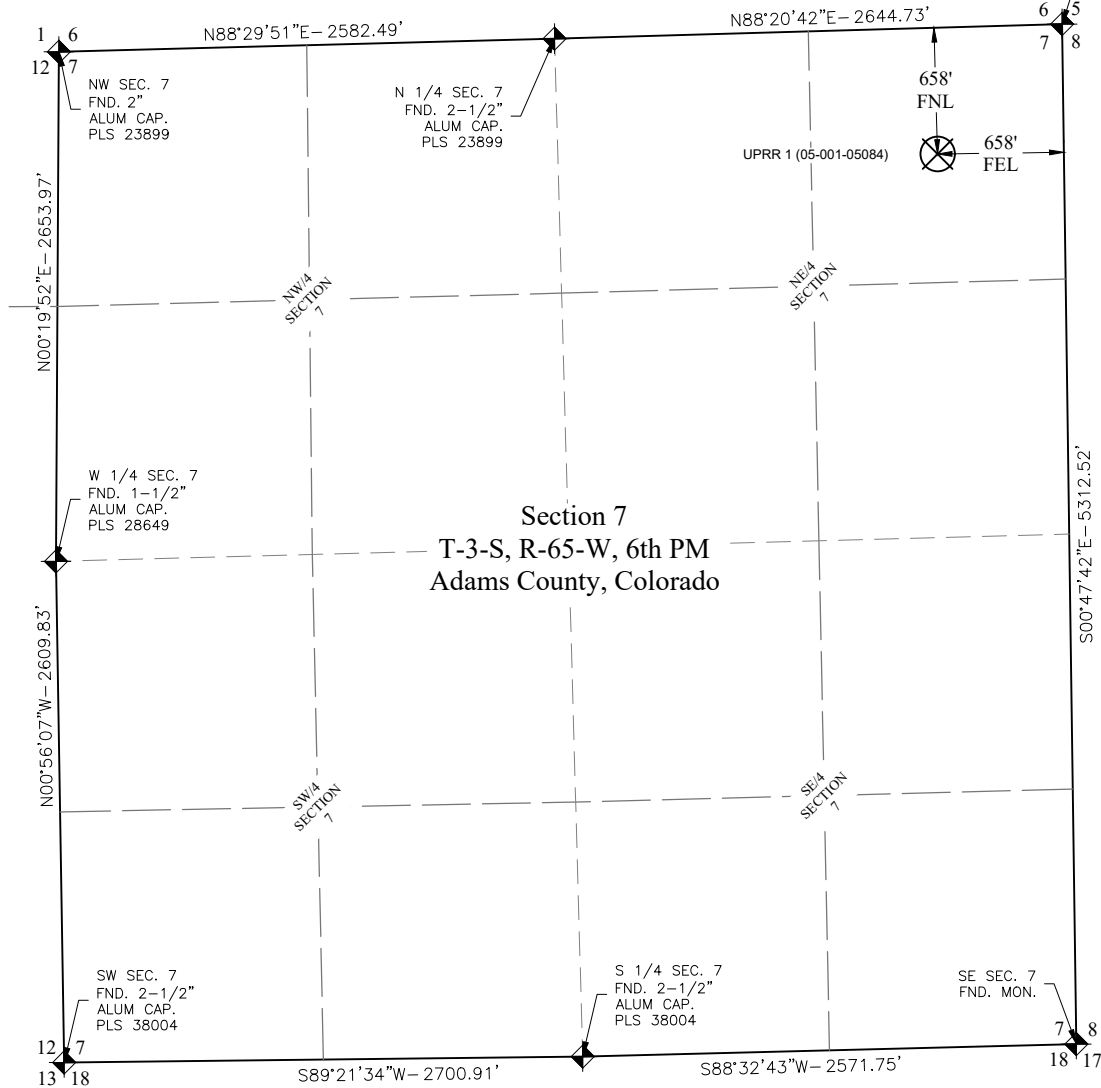

Section 7
T-3-S, R-65-W, 6th PM
Adams County, Colorado

PDOP: 1.2
INSTRUMENT OPERATOR: NATHAN NASIF
LANDMAN: CORY NEIGHBORS
SURFACE USE: RANGELAND

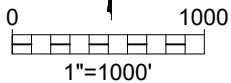

LEGEND

- ALIQUOT MONUMENT AS DESCRIBED
- CALCULATED POSITION
- ABANDONED WELL

I, STANLEY W. DRANNON, a Licensed Land Surveyor in the State of Colorado, do hereby certify that this Exhibit is a true and correct representation of a survey made on the ground under my direct supervision and all facts are as shown herein.

Stanley Drannon
Registered Professional Land Surveyor
Colorado Registration No. 38543



Avery Land Services LLC
1321 W. Main St. #522 Sterling, CO 80751



UPRR 1 (05-001-05084)

SHL (GROUND EL. 5383')

| SHL FOOTAGE | SEC 1/4-1/4 | LAT° | LONG° |
|-------------|-------------|---------|---------------|
| 658' FNL | 658' FEL | 7 NE-NE | 39.81115011 |
| | | | -104.69928548 |

DESCRIPTION: FOUND CAPPED WELL IN BELL HOLE

NOTES:

- COORDINATES, BEARINGS, AND DISTANCES SHOWN ARE LAMBERT GRID AND CONFORM TO THE COLORADO STATE PLANE COORDINATE SYSTEM, "NORTH ZONE", NORTH AMERICAN DATUM 1983, U.S. SURVEY FOOT
- DISTANCES TO SECTION LINES ARE MEASURED AT 90 DEGREES FROM SAID SECTION LINES.
- GROUND ELEVATIONS ARE BASED ON AN OBSERVED GPS ELEVATION (NAVD 1988 DATUM)
- THIS EXHIBIT WAS PREPARED WITHOUT THE BENEFIT OF A TITLE COMMITMENT. ONLY ABOVE GROUND SURFACE FEATURES WERE LOCATED AS A PART OF THIS SURVEY.
- THIS MAP DOES NOT REPRESENT A BOUNDARY SURVEY.




SECTION 7 T-3-S, R-65-W, 6th PM
ADAMS COUNTY, COLORADO

| | | |
|------------------------|-----------------|---------------|
| Survey Date: 01/08/25 | Drawn By: KRB | Chk'd By: SWD |
| Date: January 12, 2025 | SCALE: 1"=1000' | SHEET 1 OF 1 |

Bison_UPRR 1 ABD Well_01-10-25.dwg - 1/13/25 - REV 1

REFERENCE AREA PICTURES
UPRR 1 (05-001-05084)
BISON IV OPERATING, LLC

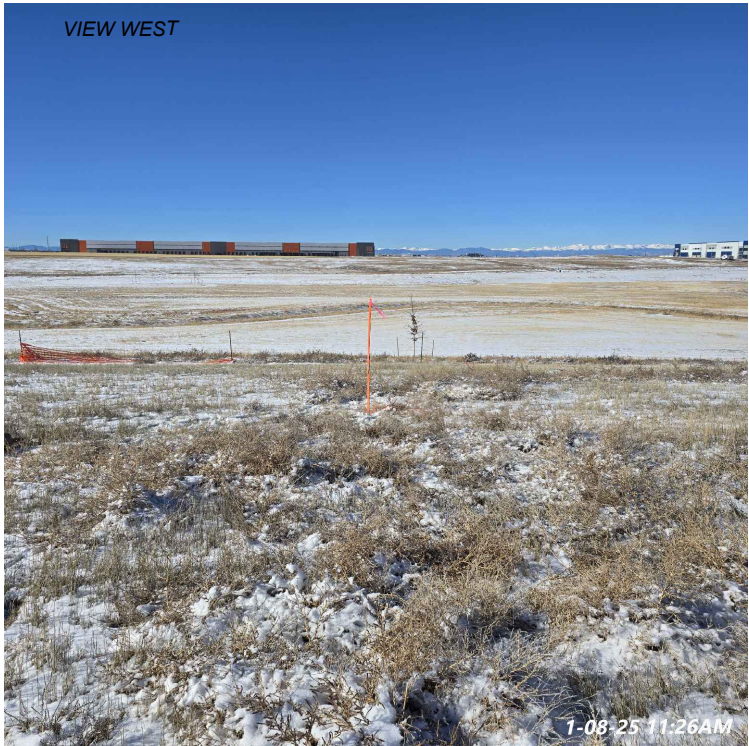

REFERENCE AREA PICTURES
UPRR 1 (05-001-05084)
LOCATION DESCRIPTION:
NE 1/4 OF NE 1/4 OF
SECTION 7 T-3-S, R-65-W, 6th P.M.
ADAMS COUNTY, COLORADO

| Revision | Date | Description |
|----------|------|-------------|
| | | |
| | | |
| | | |
| | | |

Field Date: 01/08/25
Drawing Date: 1/12/25
Drawn By: KRB
Sheet Number: 1 OF 1