


Western Operating Company

General Well Info			
Well Name:	Nelson #A-6	Field:	Johnson Hill North
Diagram Date:	1/13/2025	County:	Logan
Srf Location:	SENW 17 8N54W 6	State:	CO
Spud Date:	2/16/1954	API #:	05-075-05841
GL Elev:	4438'		
Formation Tops			

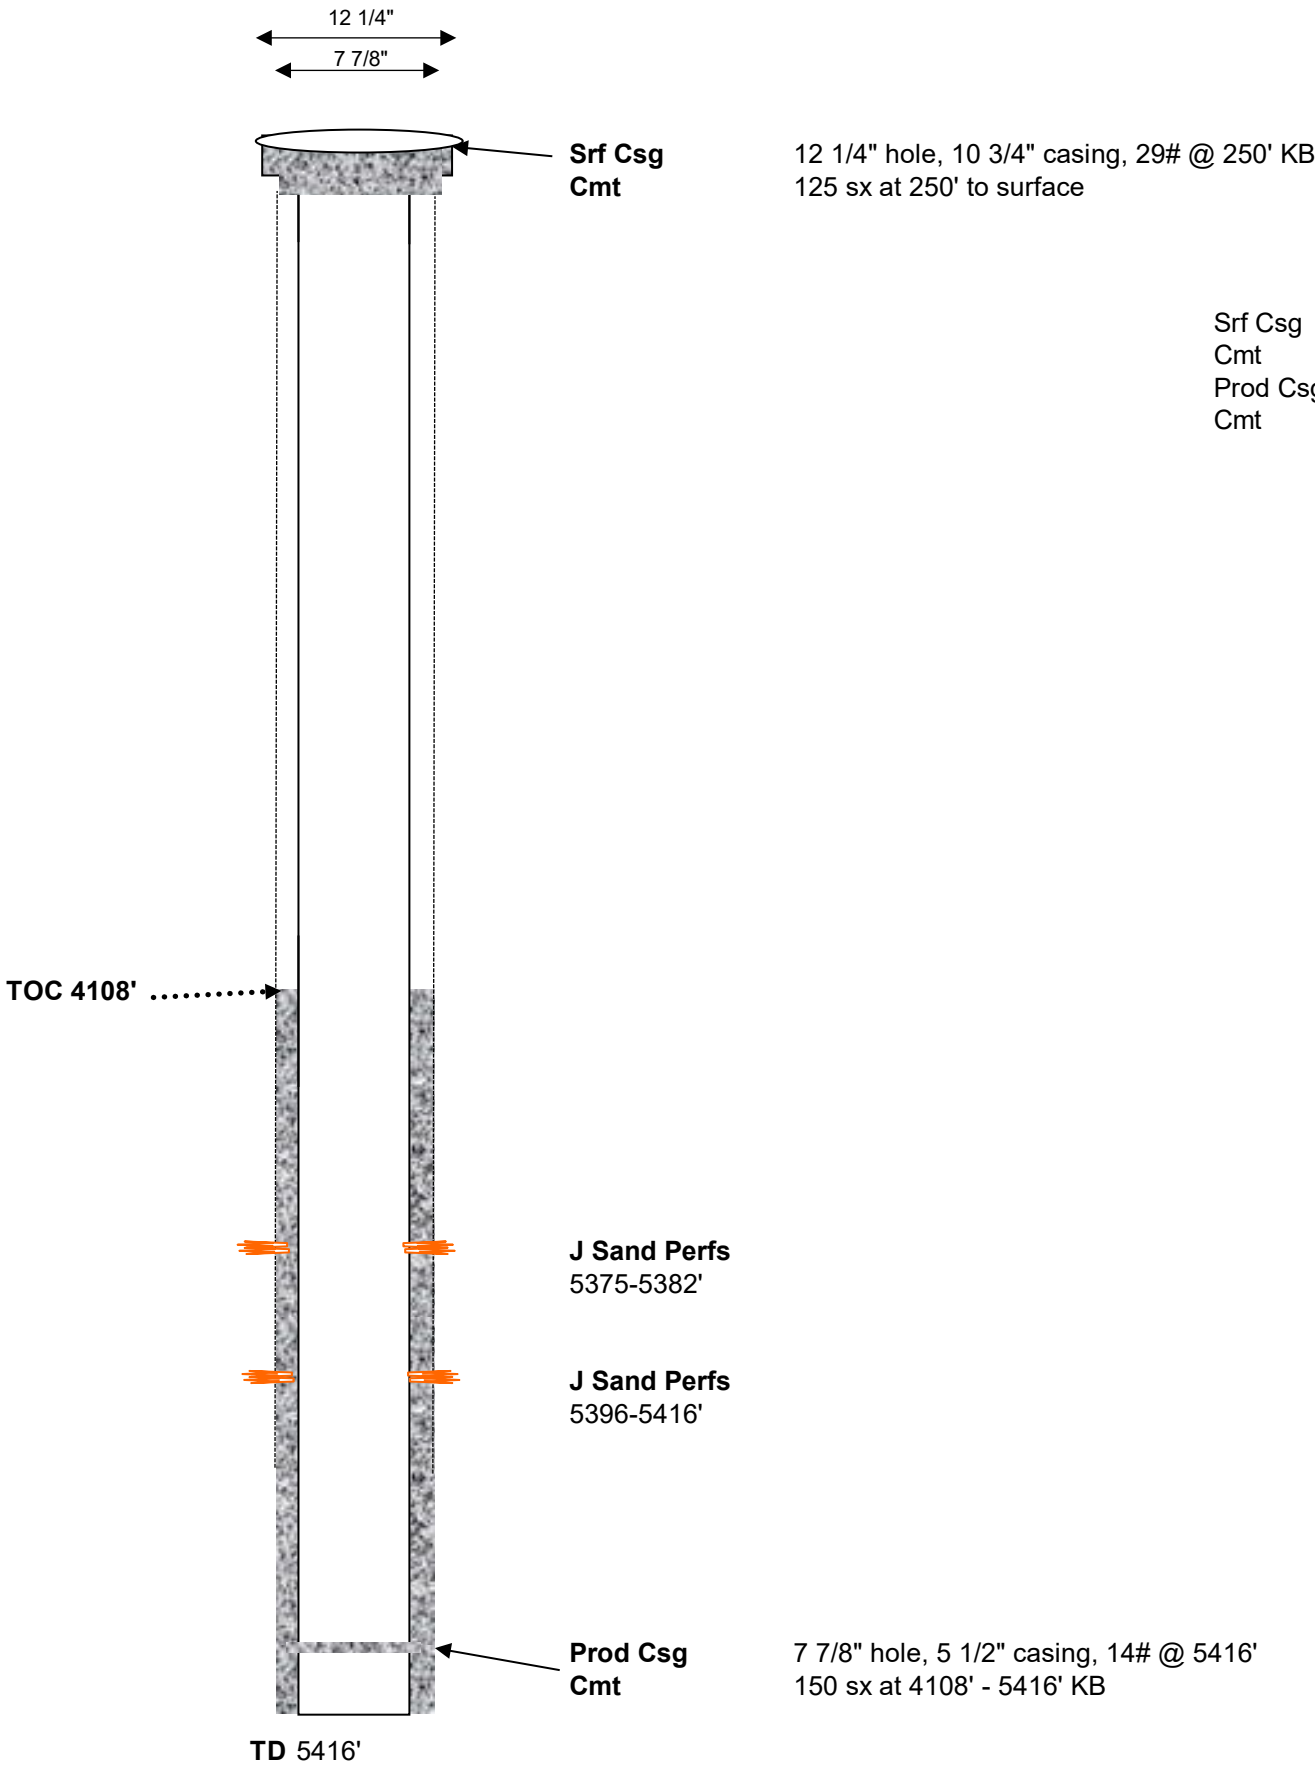

Srf Csg	12 1/4" hole, 10 3/4" casing, 29# @ 250' KB
Cmt	125 sx at 250' to surface
Prod Csg	7 7/8" hole, 5 1/2" casing, 14# @ 5416'
Cmt	150 sx at 4108' - 5416' KB

TOC Calculation		
15# cement	1.51	cuft/sx
slurry density	150	sx
Volume of cement	226.5	cuft
Piping	5.7737	ft/cuft
Cement height	1307.7431	ft
Casing Set Depth	5416	ft
Calculated TOC	4108	ft