

Inspection Photos

04/07/2025

Operator: TEP ROCKY MOUNTAIN LLC #96850

Location ID: 323868

Inspection Doc: 718100399

Garfield County, CO

Aaron Trujillo

Western Reclamation Work Lead

ECMC



COLORADO

**Energy & Carbon Management
Commission**

Department of Natural Resources

Inspection Photos

Operator Name: TEP ROCKY MOUNTAIN LLC #96850

Location ID: 323868



Photo 1: Photos 1-2 taken from the south end of the Location. Photos provide an overview from west, northwest, northeast to east.



COLORADO

**Energy & Carbon Management
Commission**

Department of Natural Resources

Inspection Photos

Operator Name: TEP ROCKY MOUNTAIN LLC #96850

Location ID: 323868



Photo 2: See comments under photo 1.



COLORADO

**Energy & Carbon Management
Commission**

Department of Natural Resources

Inspection Photos

Operator Name: TEP ROCKY MOUNTAIN LLC #96850

Location ID: 323868



Photo 3: Photos taken from the southeast interim areas of the Location, facing west and northeast. Photos examples showing interim areas that remain predominantly bare soils, and are not progressing towards ECMC 1003 standards.



COLORADO

**Energy & Carbon Management
Commission**

Department of Natural Resources

Inspection Photos

Operator Name: TEP ROCKY MOUNTAIN LLC #96850

Location ID: 323868



Photo 4: Photos examples showing vehicle/equipment tracking evident within the interim areas. Vehicle/equipment travel is required to be restricted to the designated working pad surface and access roads.



COLORADO

**Energy & Carbon Management
Commission**

Department of Natural Resources

Inspection Photos

Operator Name: TEP ROCKY MOUNTAIN LLC #96850

Location ID: 323868



Photo 5: Photo taken from the east northwest end of the Location, facing east. Photo shows areas of the Location that are not necessary for production that require reclamation pursuant to 1003 requirements.



COLORADO

**Energy & Carbon Management
Commission**

Department of Natural Resources

Inspection Photos

Operator Name: TEP ROCKY MOUNTAIN LLC #96850

Location ID: 323868



Photo 6: Photo example showing BMPs to stabilize the working pad surface show signs of disrepair.



COLORADO

**Energy & Carbon Management
Commission**

Department of Natural Resources

Inspection Photos

Operator Name: TEP ROCKY MOUNTAIN LLC #96850

Location ID: 323868



Photo 7: Wildlife protection measures at secondary containment are missing or insufficient.



COLORADO

**Energy & Carbon Management
Commission**

Department of Natural Resources

Energy & Carbon Management Commission

Juhan/14-26H, #323868 Annotation Report



Created on April 8, 2025

Captured on April 7, 2025



Point 

NAD83(2011) / Colorado Central (ftUS) (US survey foot)

Label	Title	Elevation	Lat, Long	Northing, Easting
1 	Hay storage on Interim Areas	-1.49 US ft	39.4922546, -107.8588649	1612824.9 US ft, 2334366.6 US ft
2 	Tracking	-3.84 US ft	39.4920518, -107.8592894	1612754.1 US ft, 2334244.9 US ft
3 	Secondary Containmnet	-3.20 US ft	39.4922975, -107.8598857	1612847.9 US ft, 2334079.0 US ft
4 	Temporary Juhan Booster Station	0.08 US ft	39.4915526, -107.8595914	1612574.5 US ft, 2334155.0 US ft
5 	Tracking controls show disrepair.	-3.60 US ft	39.4920838, -107.8597478	1612769.1 US ft, 2334115.9 US ft

Area 

Label	Title	Horizontal Length	Horizontal Width	Area	Surface Area
6 	Areas not necessary for production	--	--	10349.00 ft ²	10419.00 ft ²
7 	Interim Areas	--	--	1.14 acres	1.18 acres

Energy & Carbon Management Commission

Juhan/14-26H, #323868 Field Note Report



Created on April 8, 2025


Captured on April 7, 2025



5 - Observation

Open

Apr 7, 2025 at 10:50am

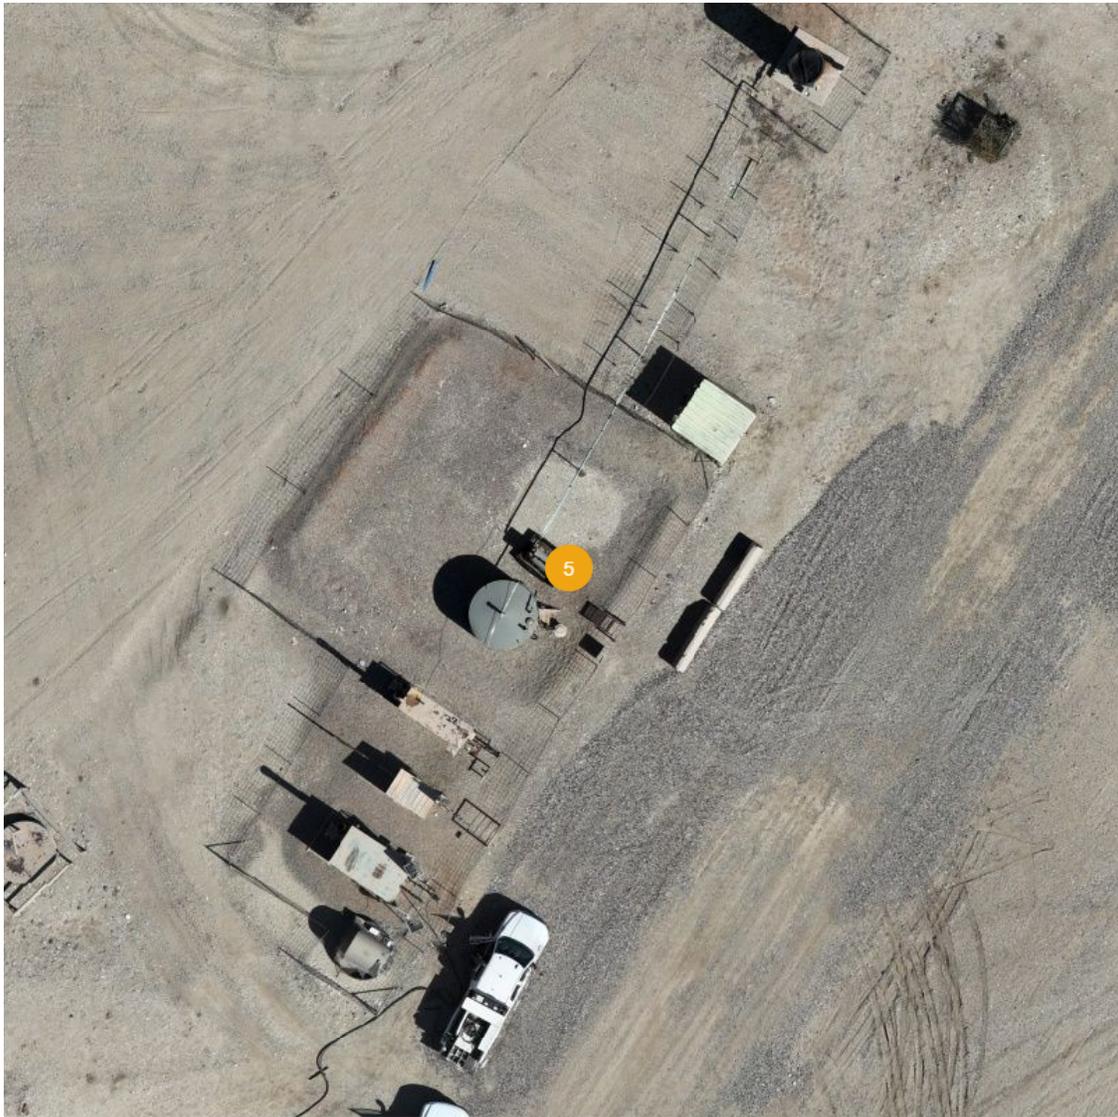

Details

Summary:

Created:

Cost of Repair:

Lat/Long:

Northing:

Easting:

Elevation:

Wildlife protection BMPs missing or insufficient.

Apr 8, 2025, 12:25pm by Aaron Trujillo

—

39.4922975, -107.8598857

1612847.9 US ft

2334079.0 US ft

-3.20 US ft

NAD83(2011) / Colorado Central (ftUS) (US survey foot)

4 - Observation

Open

Apr 7, 2025 at 10:50am




Details

Summary:	Areas not necessary for production operations are subject to 1003 requirements.
Created:	Apr 8, 2025, 8:44am by Aaron Trujillo
Cost of Repair:	—
Lat/Long:	39.49241, -107.86020
Area:	10349.00 ft ²
Surface area:	10419.00 ft ²

3 - Observation

Open

Apr 7, 2025 at 10:50am

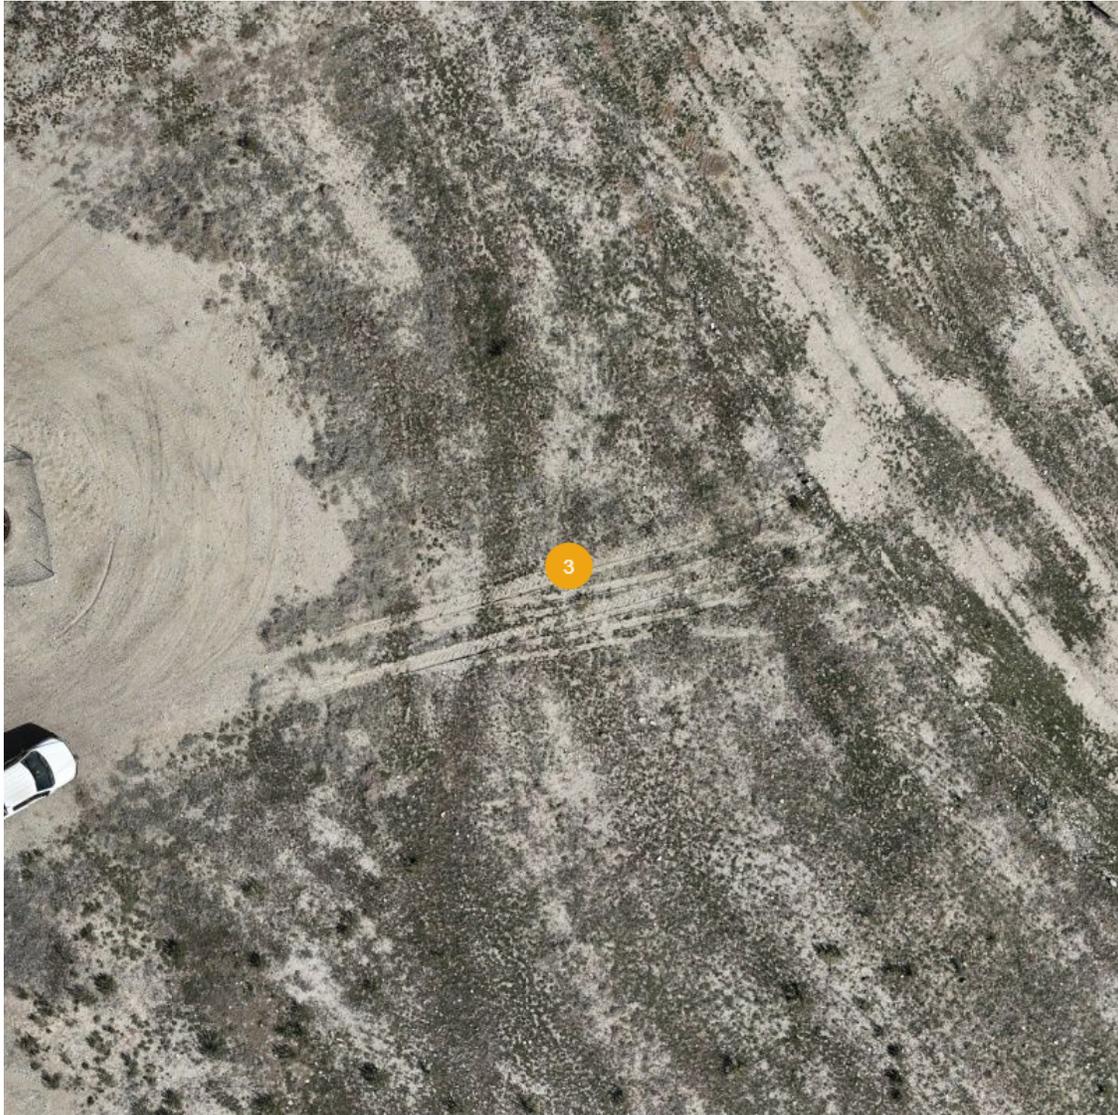

Details

Summary:	Vehicle travel beyond the designated access road, and working pad surface.
Created:	Apr 8, 2025, 8:21am by Aaron Trujillo
Cost of Repair:	—
Lat/Long:	39.4920518, -107.8592894
Northing:	1612754.1 US ft
Easting:	2334244.9 US ft
Elevation:	-3.84 US ft

NAD83(2011) / Colorado Central (ftUS) (US survey foot)

2 - Observation

Open

Apr 7, 2025 at 10:50am



Details

Summary:	Approximate interim areas that don't meet 1003 requirements.
Created:	Apr 8, 2025, 8:20am by Aaron Trujillo
Cost of Repair:	—
Lat/Long:	39.49199, -107.85868
Area:	1.14 acres
Surface area:	1.18 acres

1 - Observation

Open

Apr 7, 2025 at 10:50am



Details

Summary:	No 502.b variance to 1003 requirements has been submitted or approved
Created:	Apr 8, 2025, 8:19am by Aaron Trujillo
Cost of Repair:	—
Lat/Long:	39.4922546, -107.8588649
Northing:	1612824.9 US ft
Easting:	2334366.6 US ft
Elevation:	-1.49 US ft

NAD83(2011) / Colorado Central (ftUS) (US survey foot)