


PLUGGED AND ABANDONED WELL EXHIBIT

WILL BROS #1 (05-123-05-254)

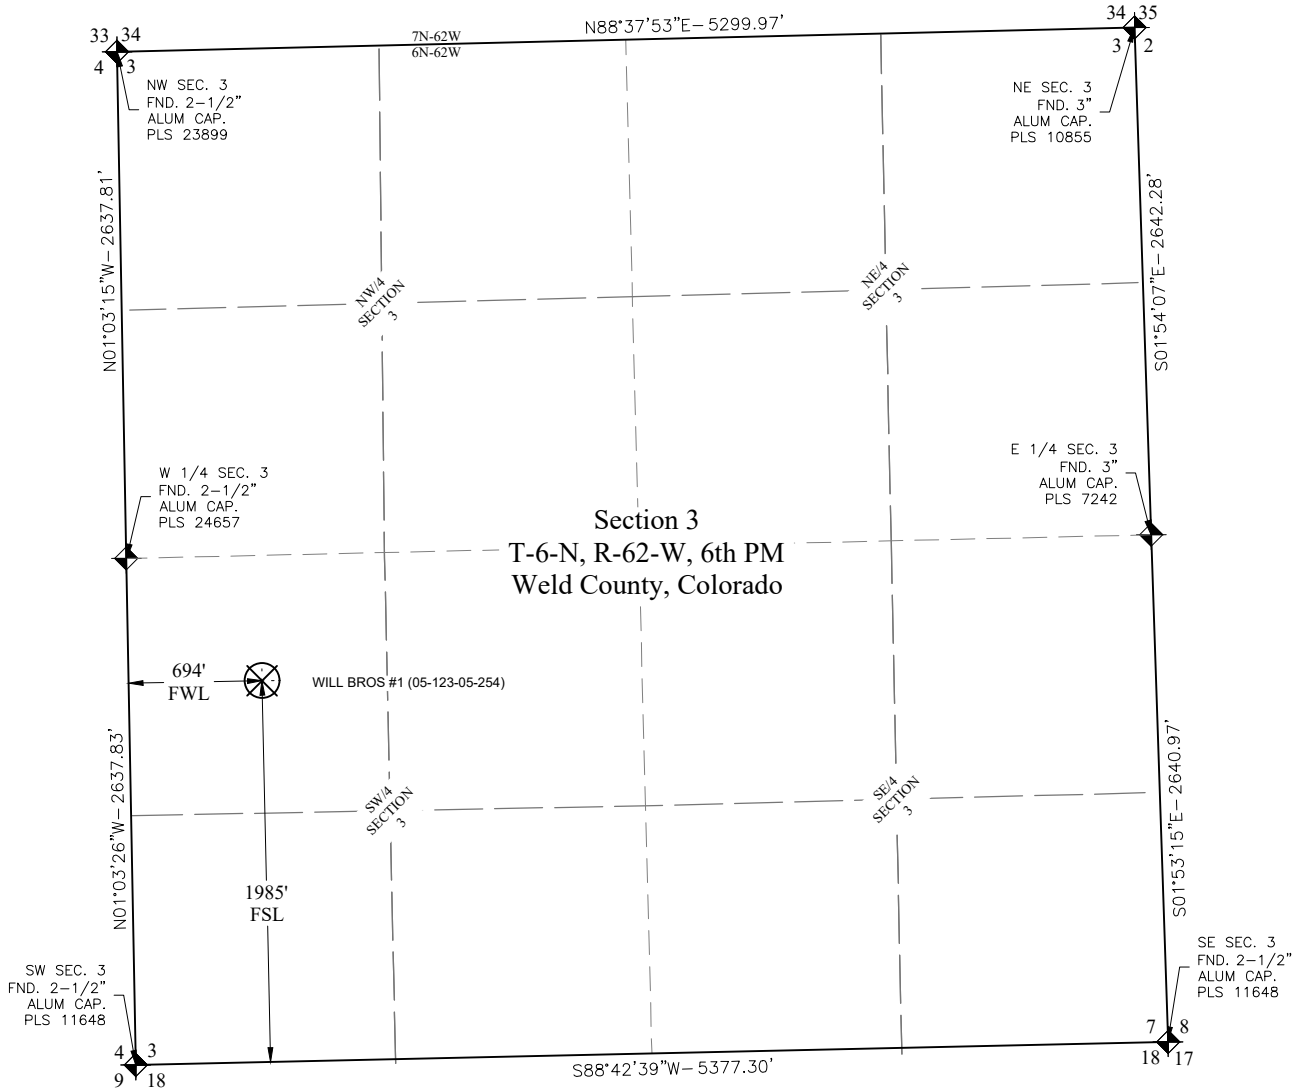

PDOP: 1.3
INSTRUMENT OPERATOR: NATHAN NASIF
LANDMAN: CORY NEIGHBORS
SURFACE USE: RANGELAND

WILL BROS #1 (05-123-05-254)

SHL (GROUND EL. 4808')

SHL FOOTAGE	SEC 1/4-1/4	LAT°	LONG°
1985' FSL	694' FWL	3 NW-SW	40.51437848
			-104.31549407

DESCRIPTION: FOUND CAPPED WELL IN BELL HOLE

NOTES:

- COORDINATES, BEARINGS, AND DISTANCES SHOWN ARE LAMBERT GRID AND CONFORM TO THE COLORADO STATE PLANE COORDINATE SYSTEM, "NORTH ZONE", NORTH AMERICAN DATUM 1983, U.S. SURVEY FOOT
- DISTANCES TO SECTION LINES ARE MEASURED AT 90 DEGREES FROM SAID SECTION LINES.
- GROUND ELEVATIONS ARE BASED ON AN OBSERVED GPS ELEVATION (NAVD 1988 DATUM)
- THIS EXHIBIT WAS PREPARED WITHOUT THE BENEFIT OF A TITLE COMMITMENT. ONLY ABOVE GROUND SURFACE FEATURES WERE LOCATED AS A PART OF THIS SURVEY.
- THIS MAP DOES NOT REPRESENT A BOUNDARY SURVEY.



SECTION 3 T-6-N, R-62-W, 6th PM
WELD COUNTY, COLORADO

Survey Date: 04/01/25	Drawn By: KRB	Chk'd By: SWD
Date: April 11, 2025	SCALE: 1"=1000'	SHEET 1 OF 1

Bison_Will Bros #1_05-123-05-254_ABD WELL_4-8-25.dwg - 4/11/25 - REV 1

LEGEND

- ALIQUOT MONUMENT AS DESCRIBED
- CALCULATED POSITION
- ABANDONED WELL

I, STANLEY W. DRANNON, a Licensed Land Surveyor in the State of Colorado, do hereby certify that this Exhibit is a true and correct representation of a survey made on the ground under my direct supervision and all facts are as shown herein.

Stanley Drannon
Registered Professional Land Surveyor
Colorado Registration No. 38543



Avery Land Services LLC
1321 W. Main St. #522 Sterling, CO 80751




REFERENCE AREA PICTURES
WILL BROS #1 (05-123-05-254)
BISON IV OPERATING, LLC

VIEW NORTH




VIEW SOUTH

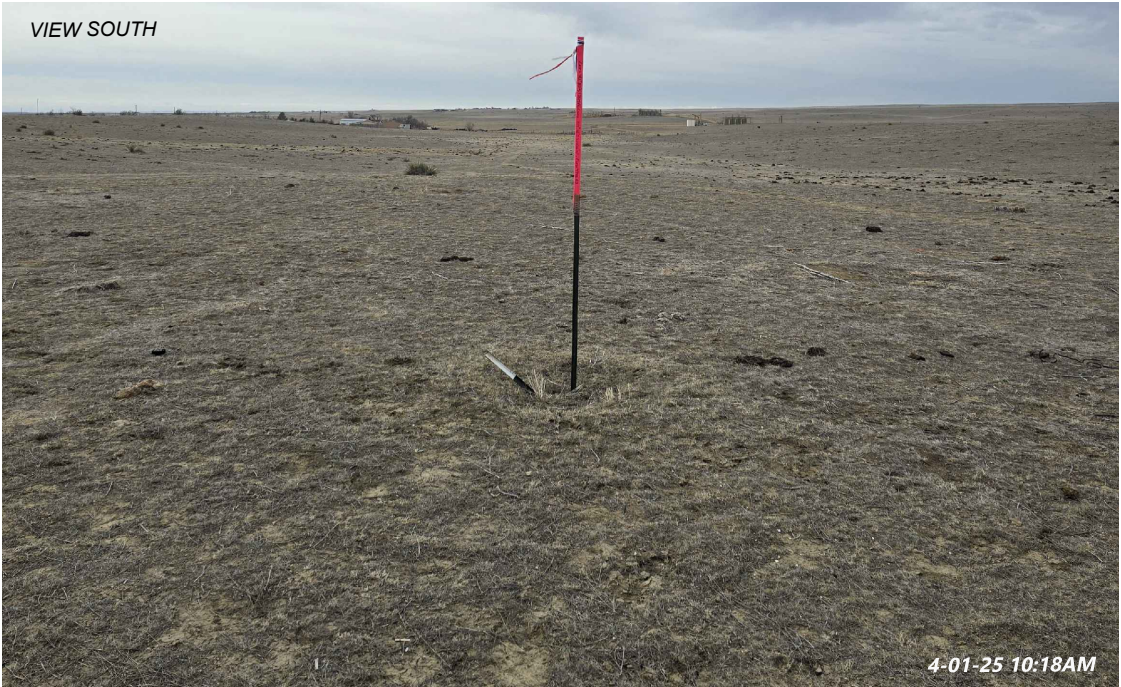

VIEW WEST



VIEW EAST

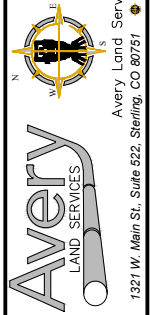

REFERENCE AREA PICTURES
WILL BROS #1 (05-123-05-254)
LOCATION DESCRIPTION:
NW $\frac{1}{4}$ OF SW $\frac{1}{4}$ OF
SECTION 3 T-6-N, R-62-W, 6th P.M.
WELD COUNTY, COLORADO

Revision	Date	Description

Field Date:
04/01/25

Drawing Date:
4/8/25

Drawn By:
KRB

Sheet Number:
1 OF 1