



FORM F-106

81-1708



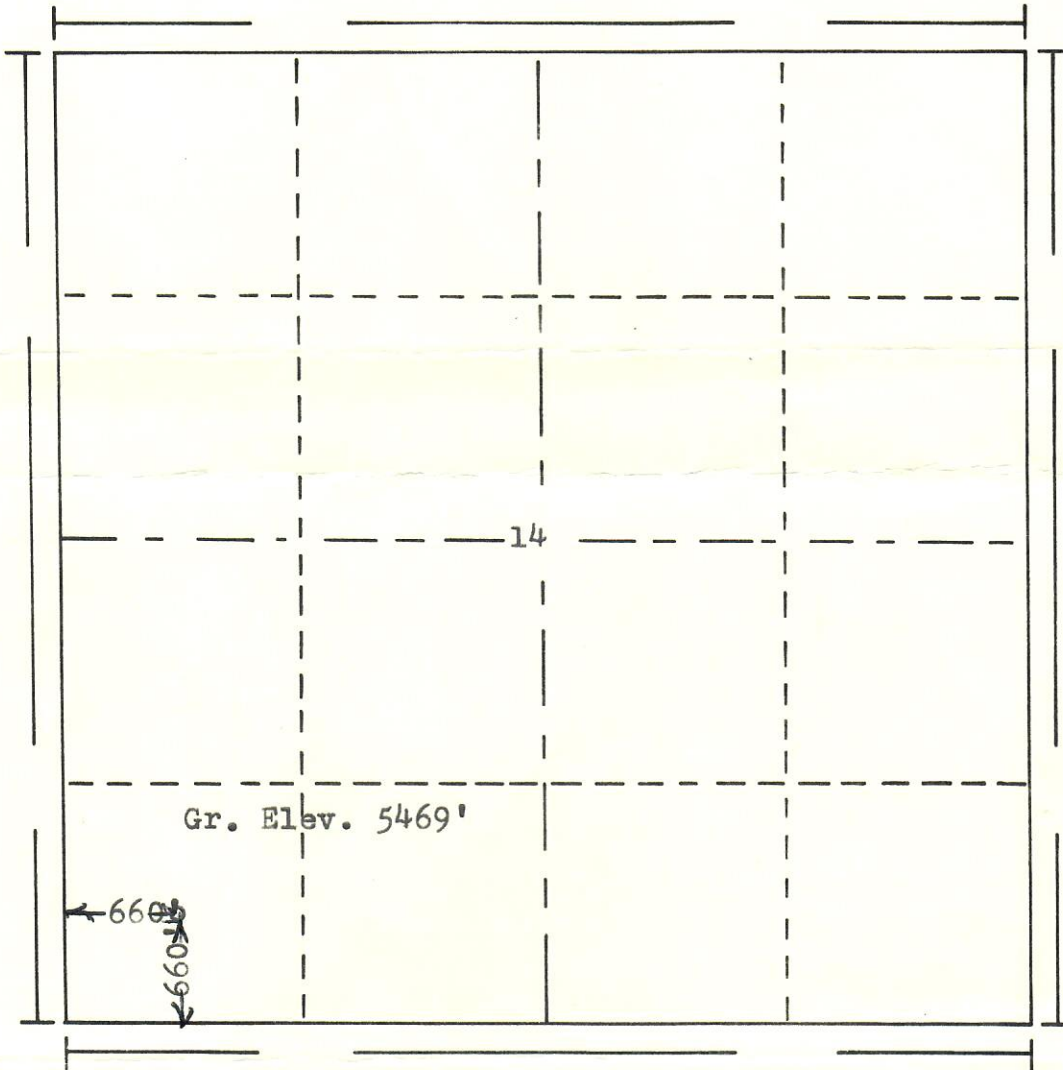
RECEIVED

OCT 13 1981


N

R. 64W

T.  
3  
S

Scale... 1" = 1000'

Powers Elevation of Denver, Colorado  
has in accordance with a request from Mr. Kaltenbacher  
for Gulf Energy Corp.

determined the location of No. 14-14 C Lisco  
to be 660'FS & 660'FW Section 14 Township 3S  
Range 64W of the 6th Principal Meridian  
Adams County, Colorado

I hereby certify that this plat is an  
accurate representation of a correct  
survey showing the location of

Date: 9-23-81

*Bill G. Holloway*  
Licensed Land Surveyor No. 2853  
State of Colorado

