



001-05104

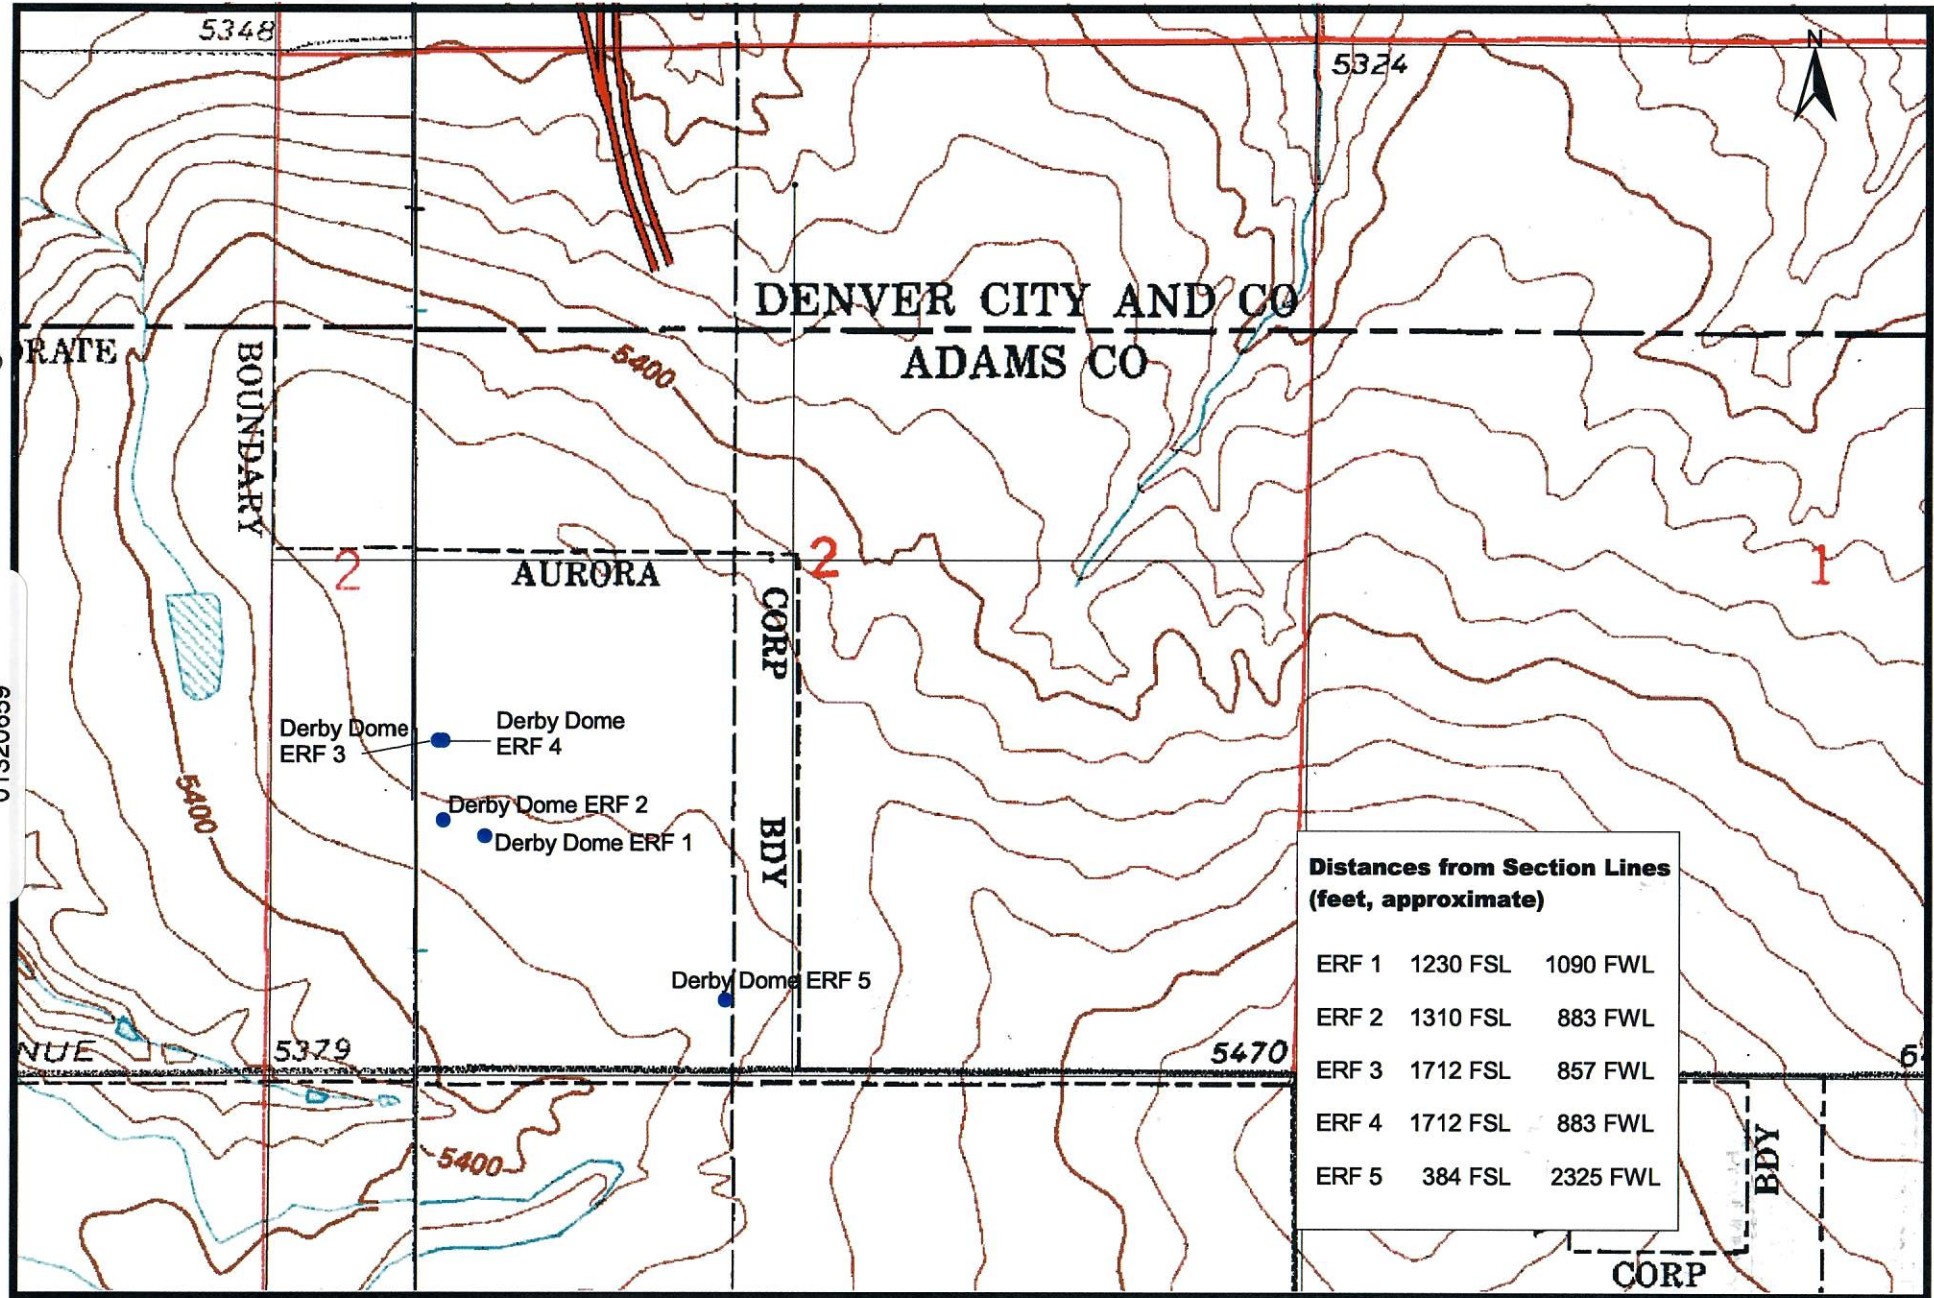

**Distances from Section Lines
(feet, approximate)**

ERF 1	1230 FSL	1090 FWL
ERF 2	1310 FSL	883 FWL
ERF 3	1712 FSL	857 FWL
ERF 4	1712 FSL	883 FWL
ERF 5	384 FSL	2325 FWL

COGCC, May 25, 2000

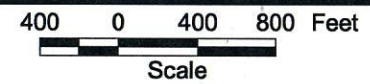

DERBY DOME SITE, SECTION 2-T3S-R66W, ADAMS COUNTY, COLORADO