

RECEIVED


OCT 20 1966

COLO. OIL & GAS CONS. COMM.

CERTIFICATE OF SURVEY
for
Patrick A. Doheny
Logan County, Colorado



T10N R53W 6PM

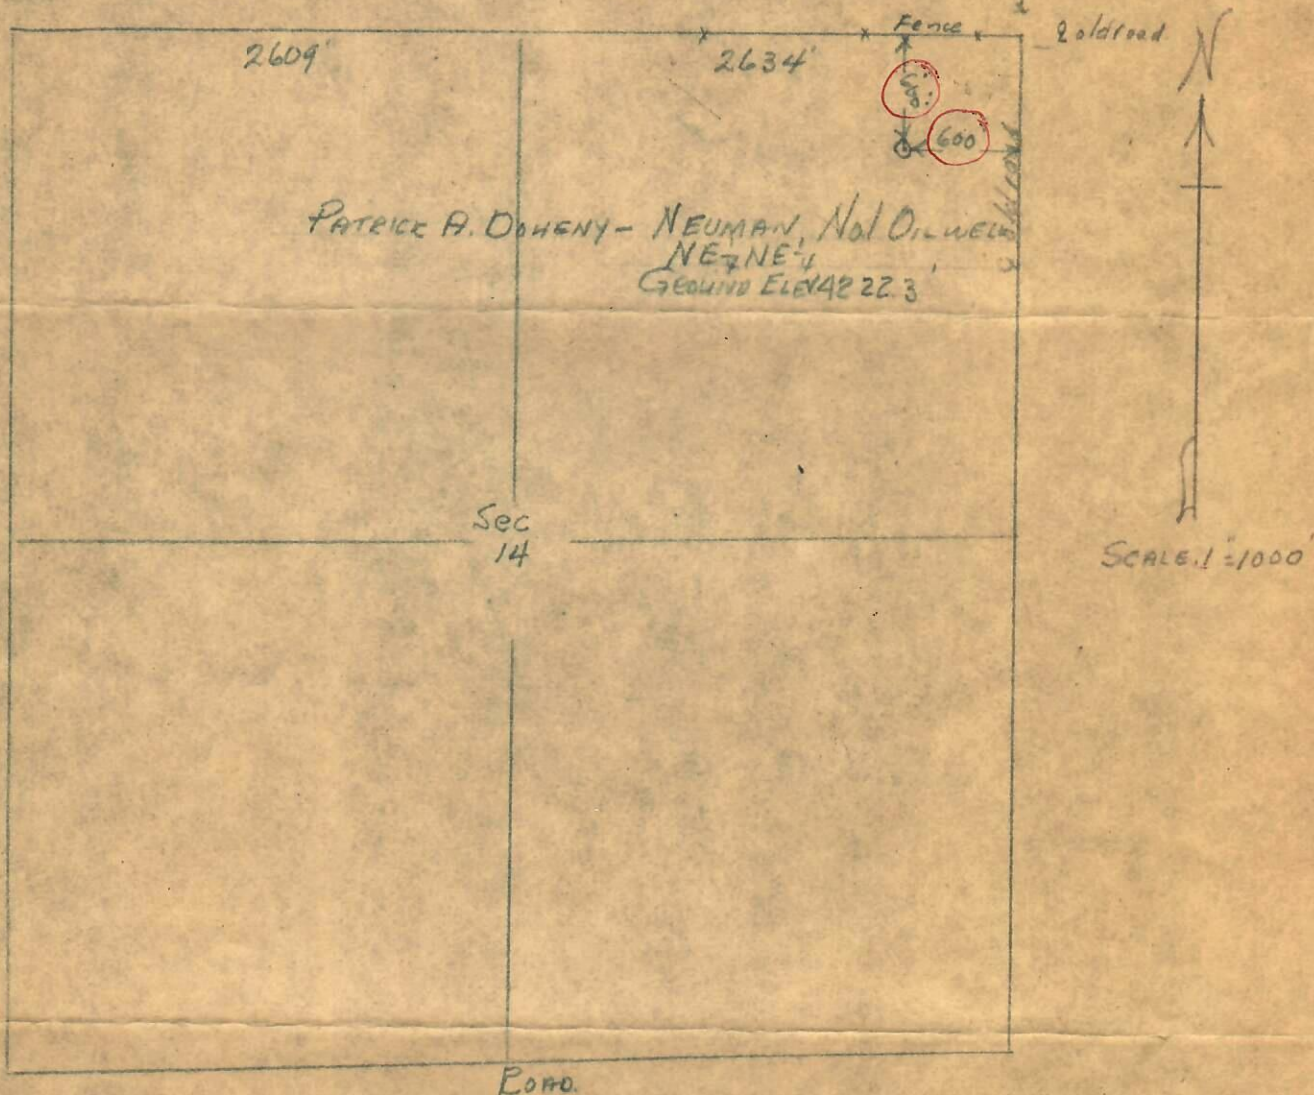

I hereby certify that the above plat is an accurate representation of a correct survey showing the location of Patrick A. Doheny-Neuman No. 1 Oilwell in NE 1/4 Sec. 14 T10N R53W 6PM. The elevation of the ground at the stake is 4222.3 feet above sea level from U.S.C.S. Bench Mark.

Fort Morgan, Colorado
October 16, 1966

Reed J. Osborne
Registered Professional Engineer
State of Colorado

66-430