

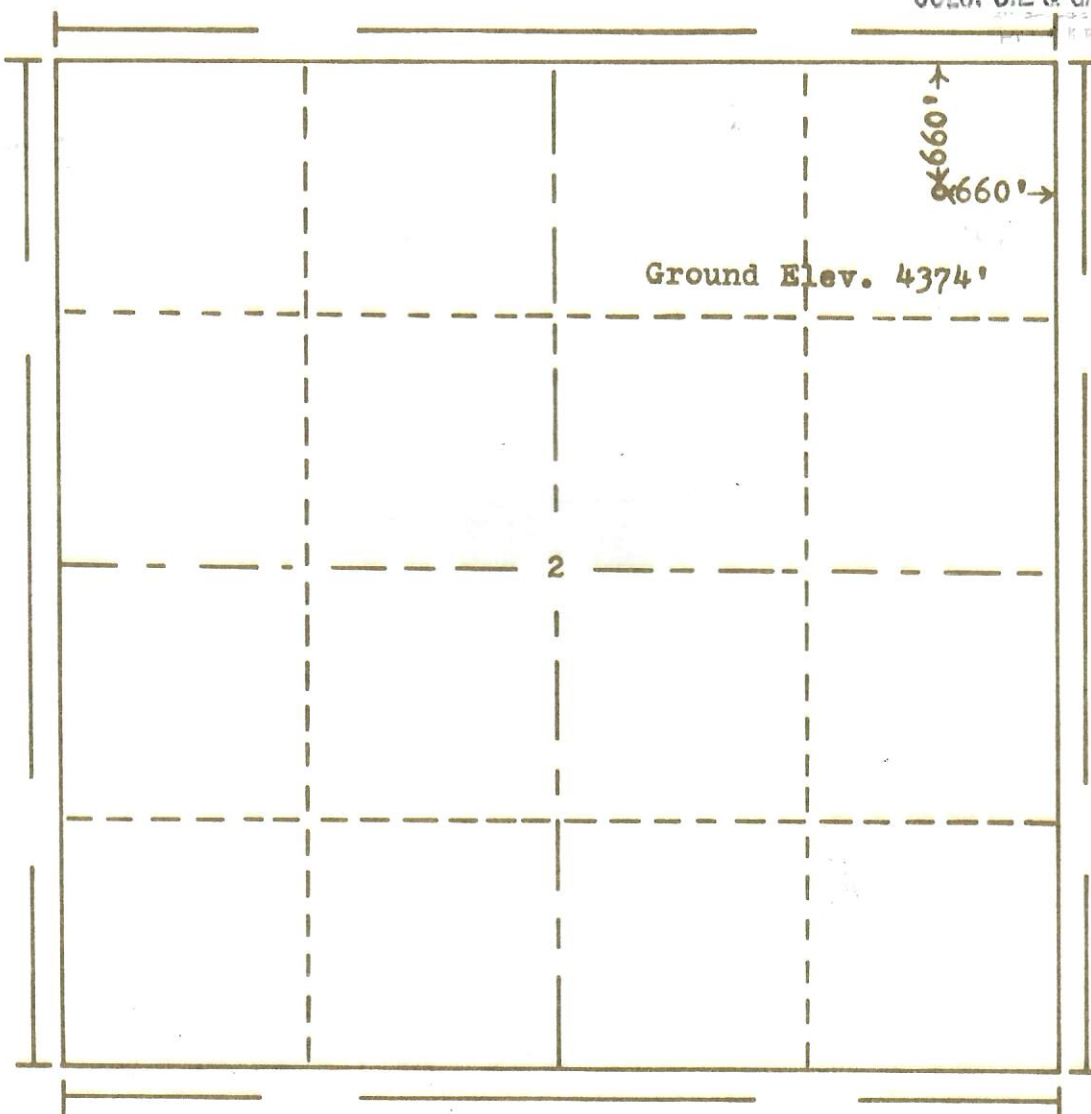


RECEIVED N

DEC 30 1968

COLO. OIL &amp; GAS CONS. COMM.

R. 53 W

T.  
10  
N

Scale... 1" = 1000'

Powers Elevation Company, Inc. of Denver, Colorado  
has in accordance with a request from George Anderson  
for United States Smelting Refining & Mining Co.  
determined the location of No. 2-1 State 1577  
to be C NE NE Section 2 Township 10 North  
Range 53 West of the 6th Principal Meridian  
Logan County, Colorado

I hereby certify that this plat is an  
accurate representation of a correct  
survey showing the location of

Date: 11-16-68

Bruce G. Hollaway  
Licensed Land Surveyor No. 2853  
State of Colorado