




RECEIVED

DEC 30 1968

COLO. OIL & GAS CONS. COMM.

R. 53 W

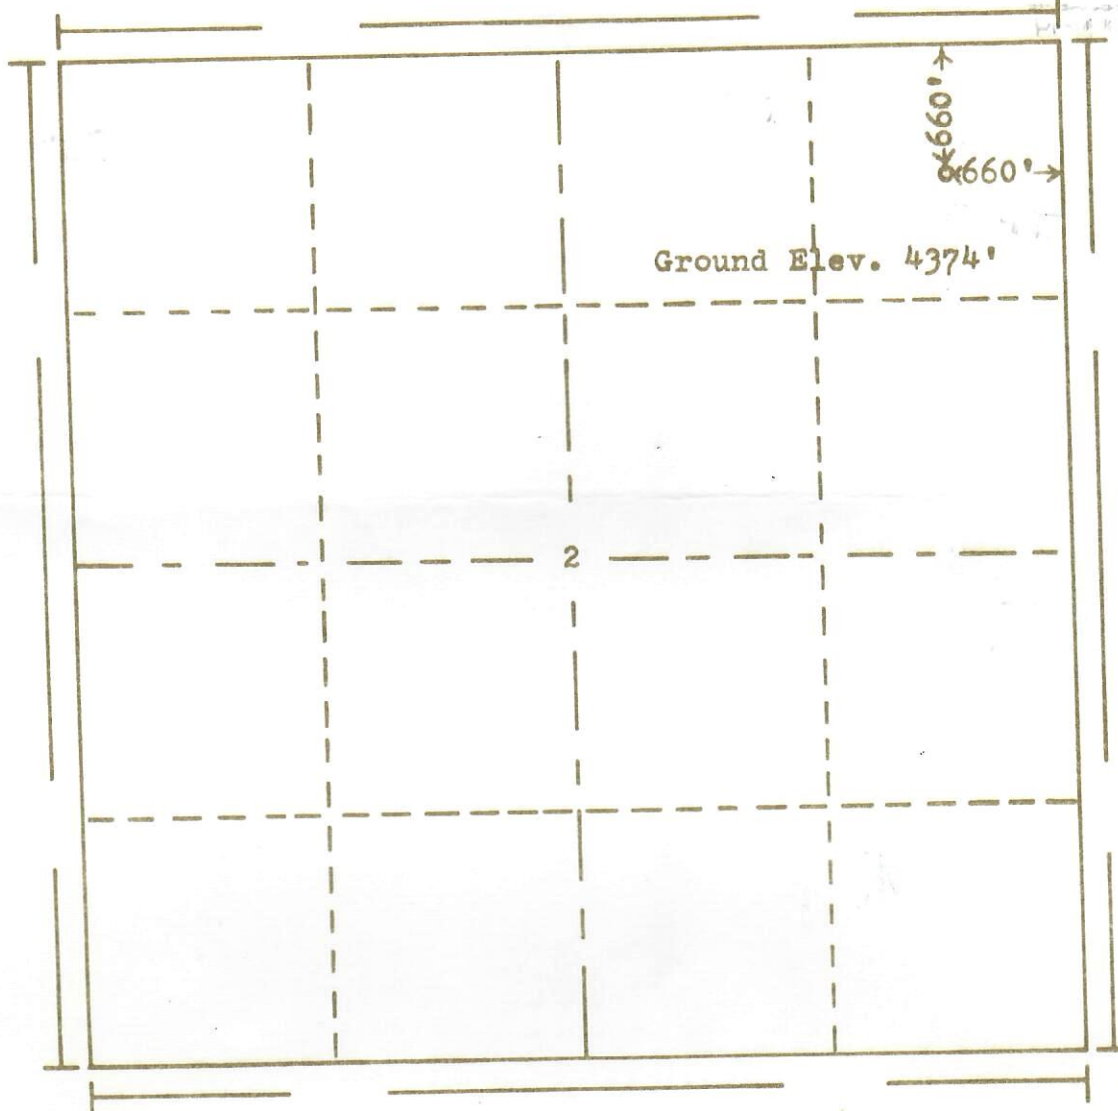

Scale... 1" = 1000'

Powers Elevation Company, Inc. of Denver, Colorado
has in accordance with a request from George Anderson
for United States Smelting Refining & Mining Co.
determined the location of No. 2-1 State 1577
to be C NE NE Section 2 Township 10 North
Range 53 West of the 6th Principal Meridian
Logan County, Colorado

I hereby certify that this plat is an
accurate representation of a correct
survey showing the location of

Date: 11-16-68

B. D. Holloway
Licensed Land Surveyor No. 2853
State of Colorado

68-562