

Inspection Photos

Location: Rainbow 23-20

Location ID: 322234

API # 05-043-06150




Location Overview



COLORADO
Energy & Carbon Management
Commission

Department of Natural Resources

Inspection Photos
Location: Rainbow 23-20
Location ID: 322234
API # 05-043-06150

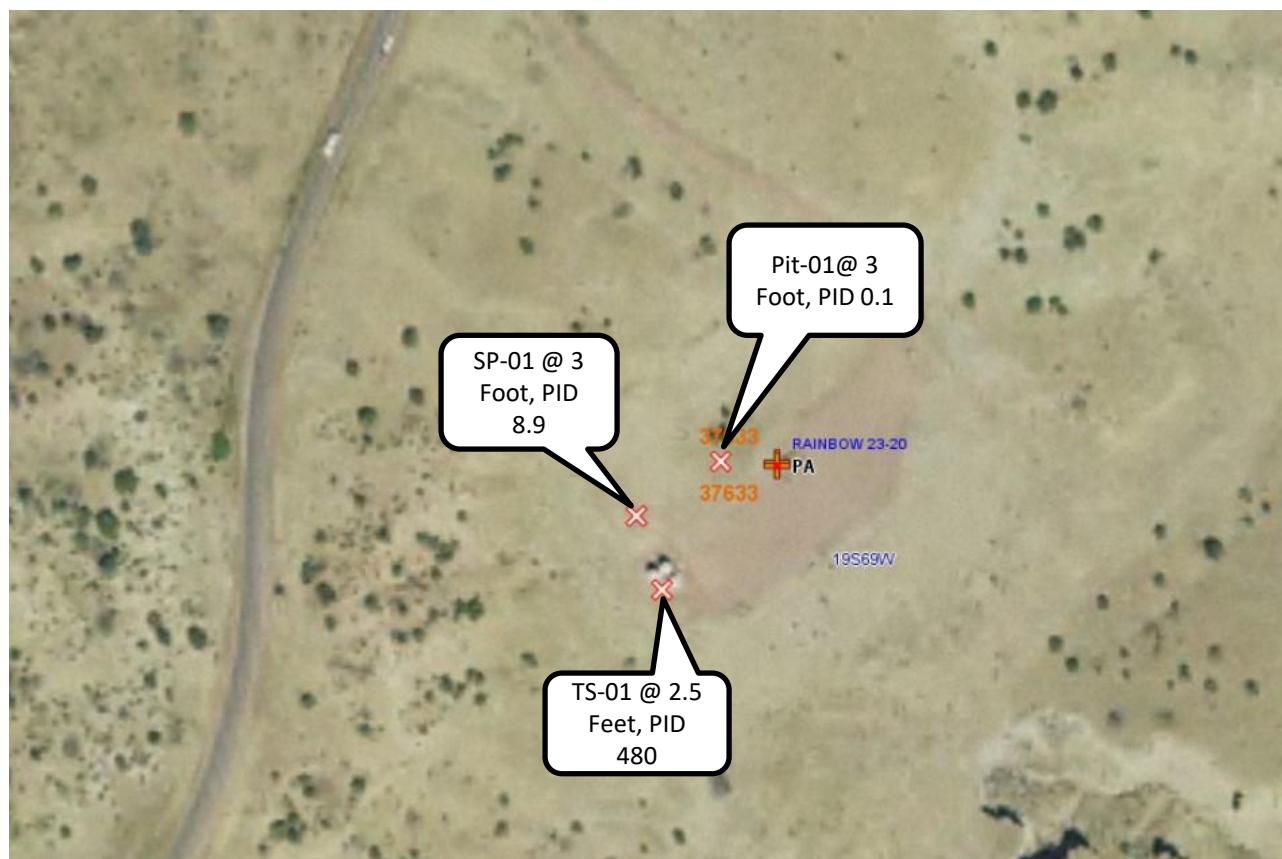

ECMC Split Sample Locations Map

