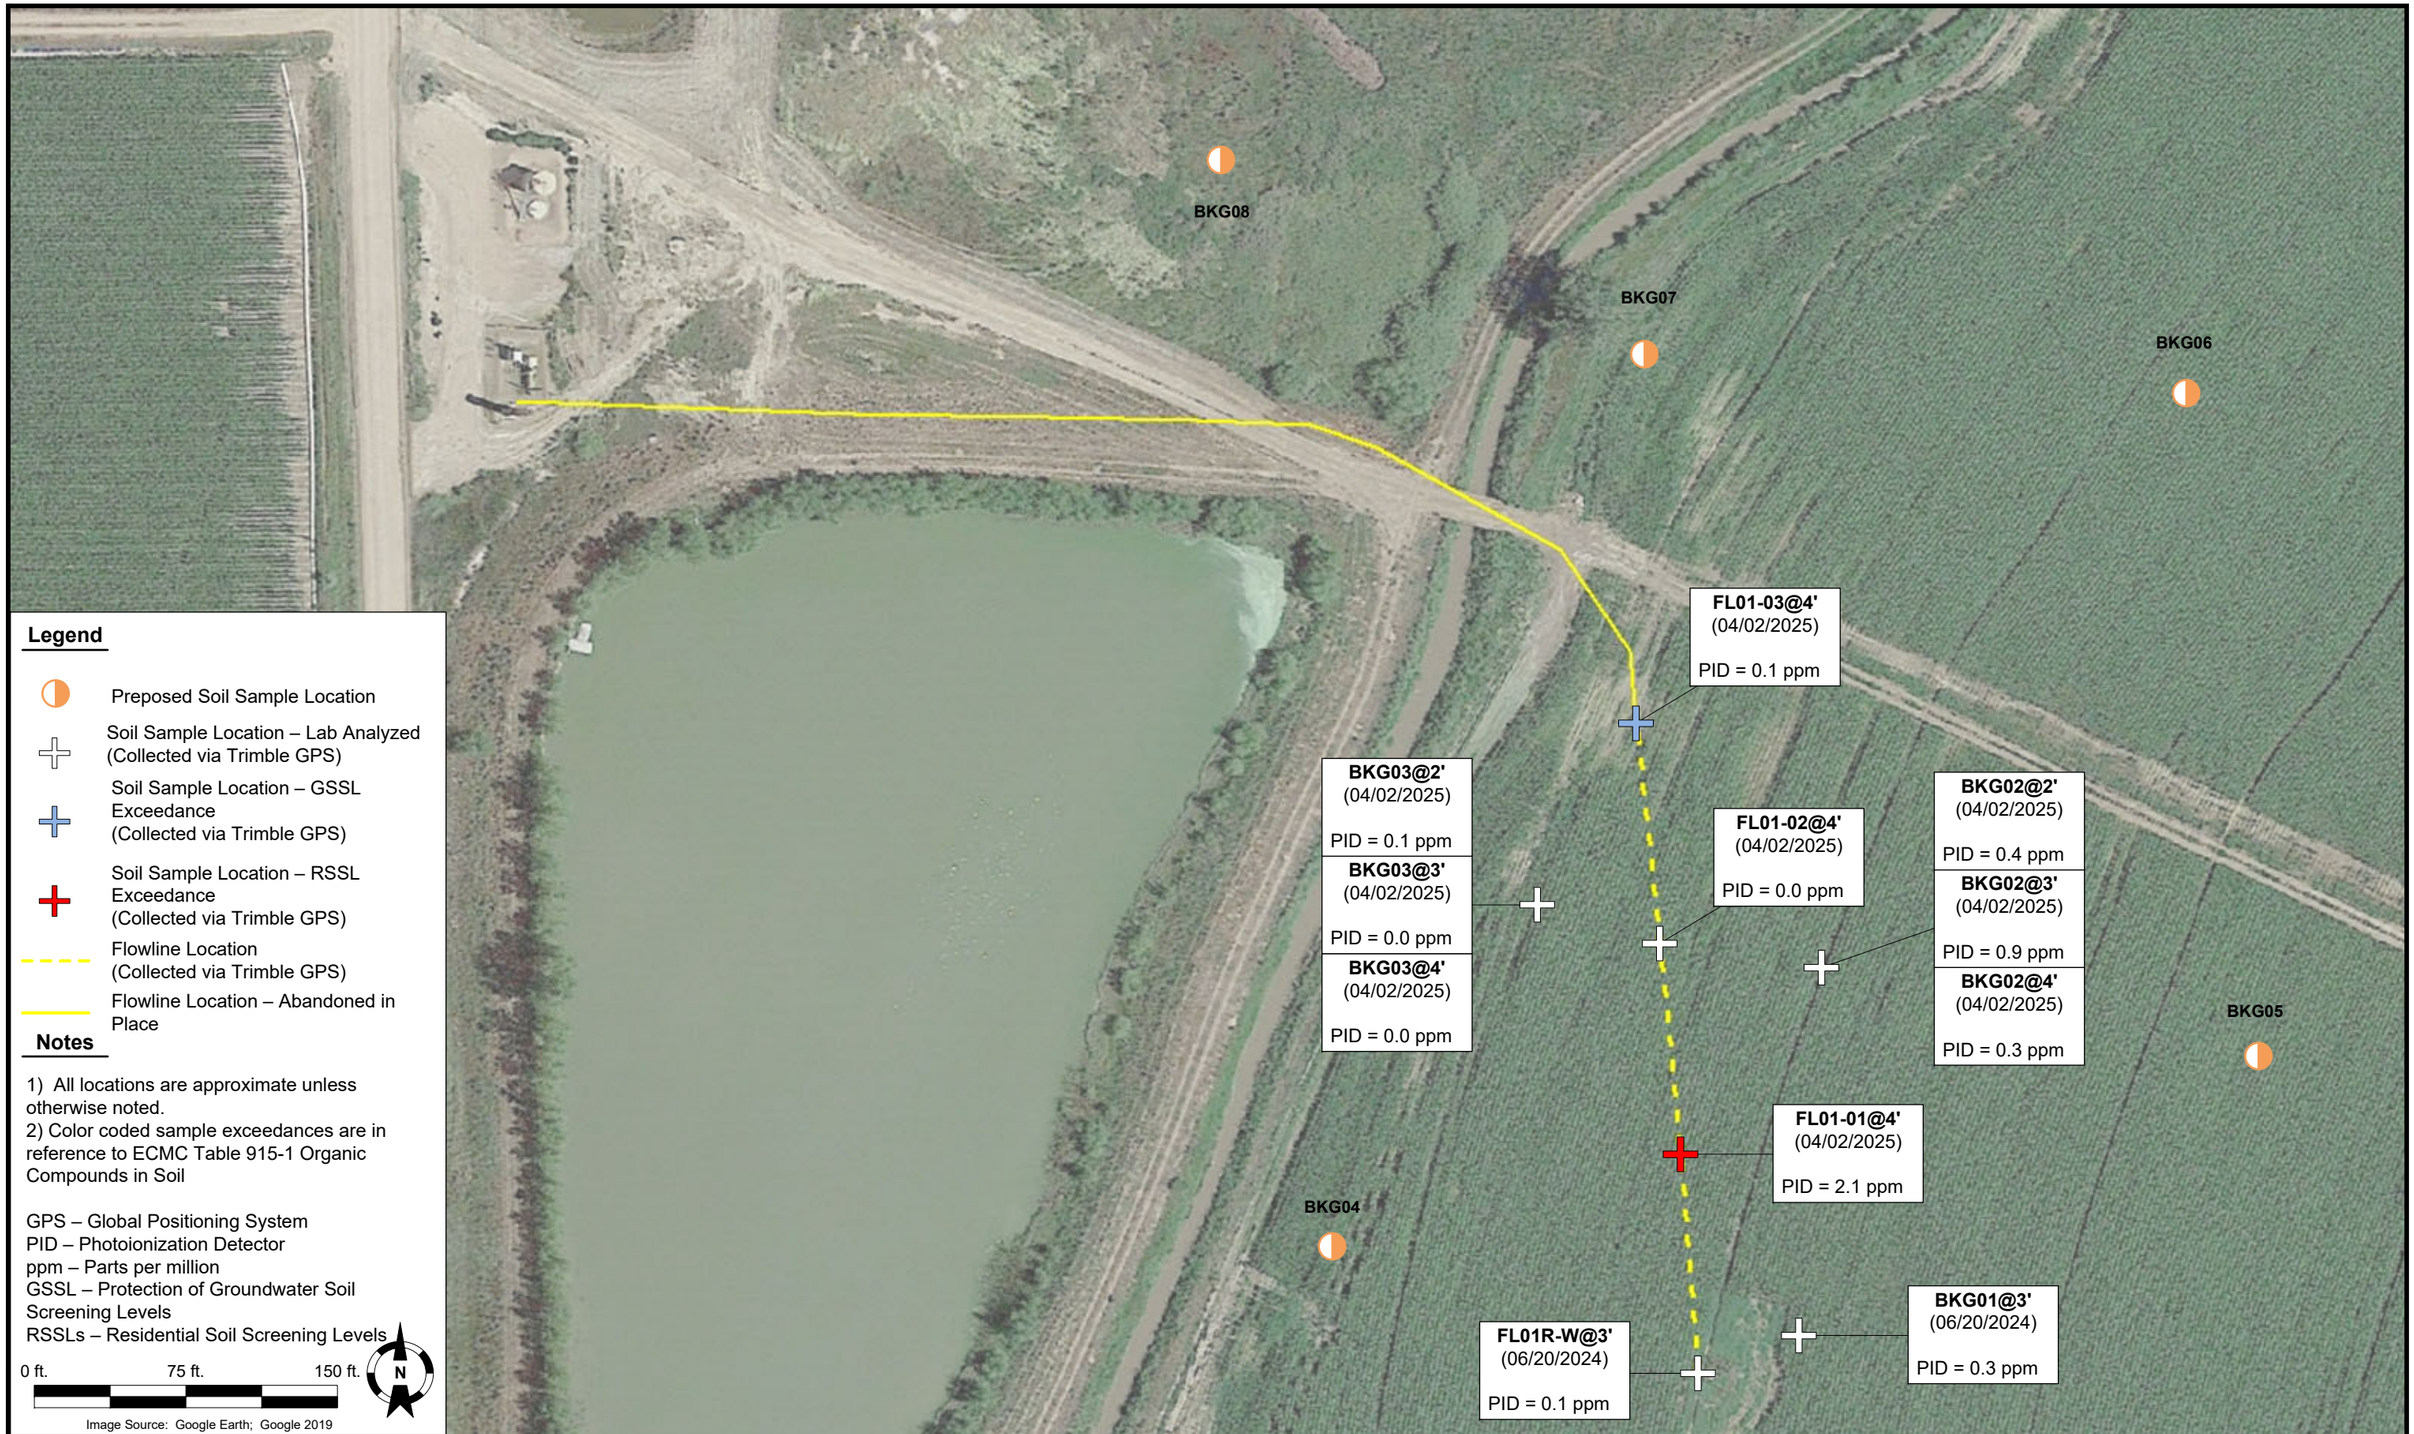

Legend

- Preposed Soil Sample Location
- Soil Sample Location – Lab Analyzed (Collected via Trimble GPS)
- Soil Sample Location – GSSL Exceedance (Collected via Trimble GPS)
- Soil Sample Location – RSSL Exceedance (Collected via Trimble GPS)
- Flowline Location (Collected via Trimble GPS)
- Flowline Location – Abandoned in Place

Notes

1) All locations are approximate unless otherwise noted.
2) Color coded sample exceedances are in reference to ECMC Table 915-1 Organic Compounds in Soil

GPS – Global Positioning System
PID – Photoionization Detector
ppm – Parts per million
GSSL – Protection of Groundwater Soil Screening Levels
RSSLs – Residential Soil Screening Levels

0 ft. 75 ft. 150 ft. N

Image Source: Google Earth; Google 2019

DATE:	June 3, 2025
DESIGNED BY:	J. Whritenour
DRAWN BY:	J. Webster

Tasman, Inc.
4725 Independence Street
Wheat Ridge, CO 80033

Noble Energy, Inc. – DJ Basin
Erickson A 4-12
NWSW, Section 4, Township 6 North, Range 64 West
Weld County, Colorado

PROPOSED SOIL
BORING LOCATION MAP