
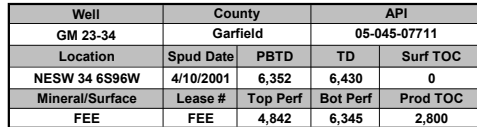


Last Updated: 6/17/2025

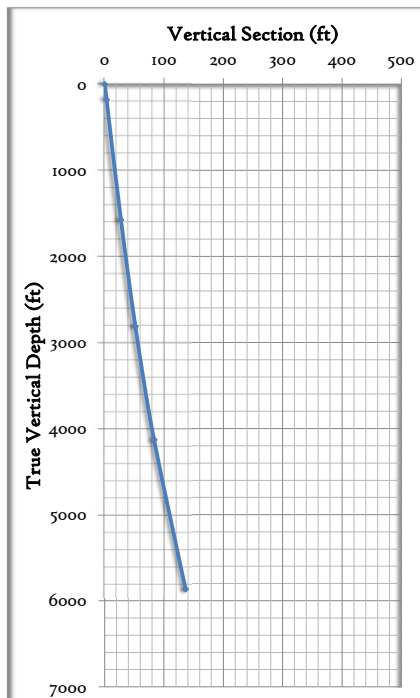

Wellbore details				
CASING DETAIL	Depth	Size	Weight	Grade
Conductor Csg				
Cement	NA			
Hole size	Notes:			
	Depth	Size	Weight	Grade
Surface Csg	303	9 5/8	32.3	H-40
Cement	180 sks			
Hole size	13 1/2	Notes:		
	Depth	Size	Weight	Grade
Prod Csg	6,419	4 1/2	11.6	I-80
Cement	980 sks			
Hole size	7 7/8	Notes:		
TUBING DETAIL	6,123	0	4.70	J-55
Current EOT	85%	Notes:		

Formation Top	Depth (ft)
Wasatch G	1,663
Fort Union	1,966
MesaVerde	3,360
Cameo	5,875
Rollins	6,402

[illegible]