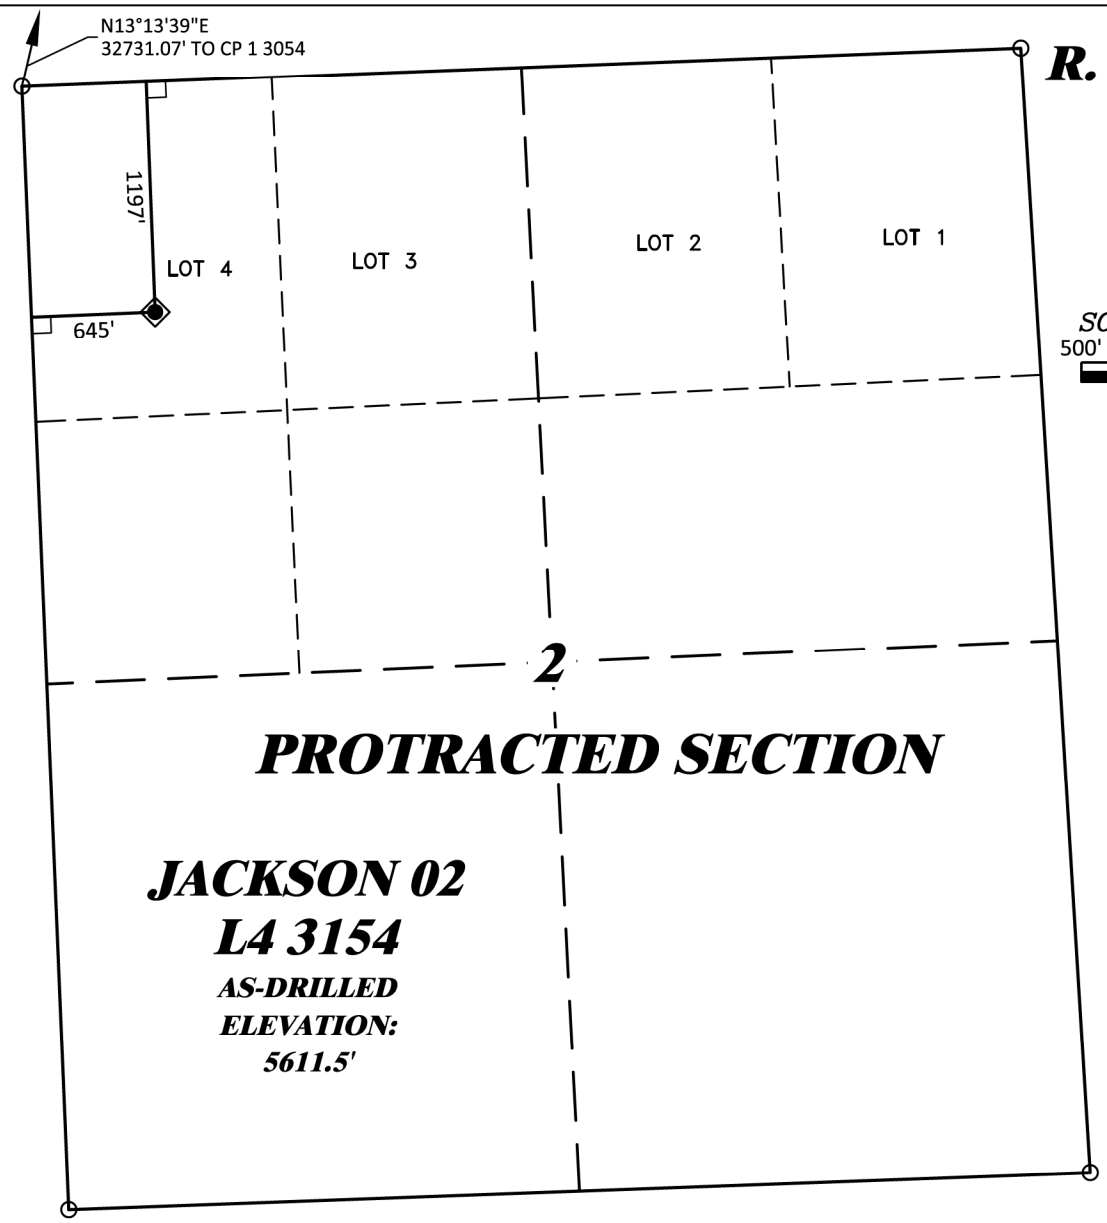

R. 54 W.

N

GRID NORTH

SCALE' 1" = 1000'

500' 0 1000'

T. 31 S.

SHL

LATITUDE (NAD 83)

NORTH 37.377605 DEG.

LONGITUDE (NAD 83)

WEST 103.443730 DEG.

NORTHING (NAD 83)

1265442.67

EASTING (NAD 83)

3597452.96

BASIS OF BEARINGS, ELEVATIONS & DATUM

SPCS COLORADO SOUTH NAD 27 BASED ON GPS OBSERVATIONS AND OPUS SOLUTION ON 1½IN. ALUM. CAP ON No. 5 REBAR DRG CONTROL POINTS:
"CP 1 3054" HAVING A NAD83(2011) POSITION OF:
LAT 37° 28' 04.42" NORTH
LONG 103° 25' 04.13" WEST
NAVD88 ELEVATION: 4811.45'
"CP 35 2954" HAVING A NAD83(2011) POSITION OF:
LAT 37° 28' 39.68" NORTH
LONG 103° 26' 15.82" WEST
NAVD88 ELEVATION: 5309.79'

BEARINGS HEREIN RELATIVE TO GRID BEARING BETWEEN SAID POINTS:
S59°35'36"E

NOTES

1. GPS OPERATOR T.SHERRILL OBSERVED A PDOP OF 1.4.
2. ALL GPS OBSERVATIONS ARE IN COMPLIANCE WITH COGCC RULE No.215.

LEGEND

- WELL LOCATION
- DENOTES 90° TIE
- PROTRACTED QUADRANGLE INTERSECTION LOCATION

SURVEYOR'S STATEMENT

I, DAVID E. HENDERHAN, AN EMPLOYEE AND AGENT ON BEHALF OF D.R. GRIFFIN & ASSOCIATES, INC. STATE THE PLAT HEREON IS A CORRECT REPRESENTATION OF A SURVEY MADE UNDER MY SUPERVISION ON THE 22ND DAY OF APRIL, 2025 OF THE SHOWN JACKSON 02 L4 3154 AS-DRILLED LOCATION.

COLORADO LICENSED PROFESSIONAL LAND SURVEYOR
DAVID E. HENDERHAN
4/29/25
38109

COLORADO PLS No. 38109

Notice: In accordance with Colorado State Law, any legal action based upon any defect in this survey plat must commence within three (3) years after first discovery of such defect. In no event, may any action based upon any defect in this survey plat be commenced more than ten (10) years from the date of certification shown hereon.

JACKSON 02 L4 3154

DRG RIFFIN & ASSOCIATES, INC.
(307) 362-5028
1414 ELK ST., ROCK SPRINGS, WY 82901

PLAT OF AS-DRILLED LOCATION IN LOT 4, SECTION 2, FOR BNL (ENTERPRISE) INC.

DRAWN: 4/28/2025 - NGJ	SCALE: 1" = 1000'
REVISED: N/A	DRG JOB No. 22267
	EXHIBIT AS DRLD

1,197' F/NL, & 645' F/WL, SECTION 2, T. 31 S., R. 54 W., 6TH P.M., LAS ANIMAS COUNTY, COLORADO