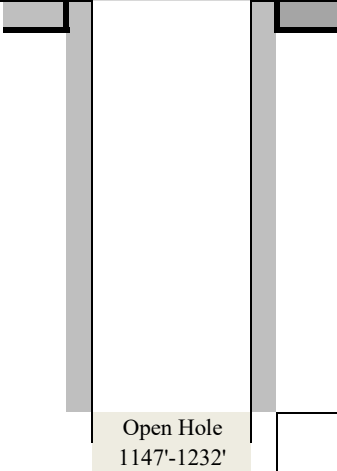


<div><div><div>BNL</div><div>ENTERPRISE</div></div><div>Enterprise (BNL) Inc</div><div>JACKSON #2 Lot 4 3154</div><div>05-071-09942</div><div>Lyons Formation</div><div>Las Animas</div><div>Colorado</div></div>	Operator: Enterprise (BNL) Inc COGCC Operator Number: 10763 Well Name & Number: JACKSON #2 Lot 4 3154 API: 05-071-09942 Producing Formation: Lyons Formation Qtr/Qtr; Sec Twn-Rng; Meridian Lot 4 Section 2 31S-54W; 6th PM Surface Spot: 1197 FNL, 645 FWL <i>Surface Latitude, Longitude:</i> 37.377605° -103.443730° Well Vertical or Directional: Vertical Bottom Hole Location: Same as Surface County: Las Animas State: Colorado Field: Wildcat Ground Elevation, feet: 5,612 KB Elevation, feet: 5,616 PBDT: 1,232 TD 1,232			Surface Owner Everett & Flo Jackson Rig: Andreatta Spud Date: 4/28/2025 Surface Casing Date: 5/1/2025 TD Date: 5/3/2025 Rig Release Date: 5/4/2025 Wellhead Date: 5/4/2025 Shut-in Date: 5/5/2025		6/29/2025 PEK
	KB		Cased Hole Log: CBL Open Hole Log: GR, DEN, NEU, DIL			
	4					
Wellbore Diagram	Hole Size	Casing & Cement	Depth	Formation	MD/TVD	Subsea, KB
	12 1/4"	Conductor Casing: 9 5/8" J-55, 36#, STC Set & Cemented 4/28 14 Sacks, Cement to Surface	0-40'	Alluvium	0	5,616
				Dakota	5	5,611
				Purgatorie	112	5,504
				Morrison	295	5,321
				Cheyenne	NA	NA
				Cheyenne Base	NA	NA
				Morrison 2	NA	NA
				Entrada	644	4,972
				Day Creek	908	4,708
				Lykins	1,040	4,576
				Blaine	1,090	4,526
				Lyons	1,147	4,469
				TD	1,232	4,384
Open Hole 1147'-1232'	6 1/8"	Open Hole	1147'-1232'			