

BLEDSOE 6-7-5-44

API # 125-10795 Loc. # 337950

FIELD NAME BALLYNEAL - #1970

Spud Date 5/1/2007

Basin DENVER - JULESBURG

Location SENW 7 5N 44W 6

Elevation GL (ft) 3752


Elevation KB (ft) 3757

TD (ft) 2710

PBTD (ft) 2640

Formation Tops

NIOBRARA - 2467'

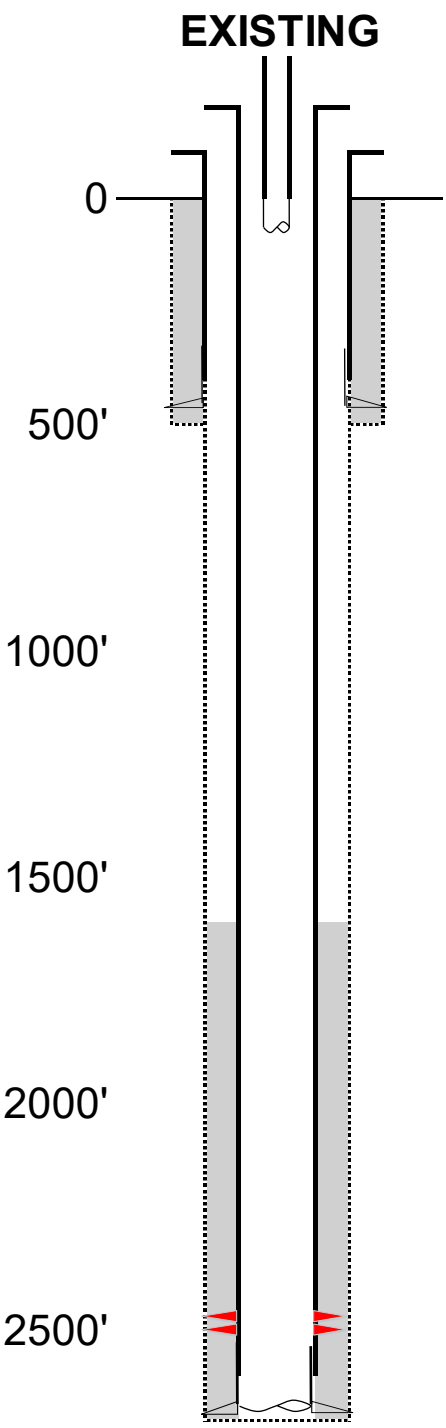

Existing Casing and Cement Coverage

SURF: Size: 7", Hole Size: 9.875 in.  
Depth: 486 ft., Weight: UNK  
Cement: 180 sx, Top: 0 ft., Method: Vis

Deepest DWR w/in 1 mi.= 300'

1ST, Size: 4.5", Hole Size: 6.25"  
Depth: 2687', Weight: UNK  
Cement: 100 sx, TOC: 1625', Method: CBL

tubing UNK  
TOC = 1625' (CBL)  
NBRR Perfs 2486' - 2496'  
PBTD (ft) 2640'  
TD (ft) 2710'

NIOBRARA - 2467'

