




T000

71.61 acres

T000 Grid Sampling 4/29
Parcel Sampling Locations
Bishop Loss of Containment


SW¼ SE¼ Section 36, Township 7N, Range 65W

-  Incident Location
-  Agricultural Grid - 10 Acre
-  Grid Soil Sampling Location
-  Parcel Boundary

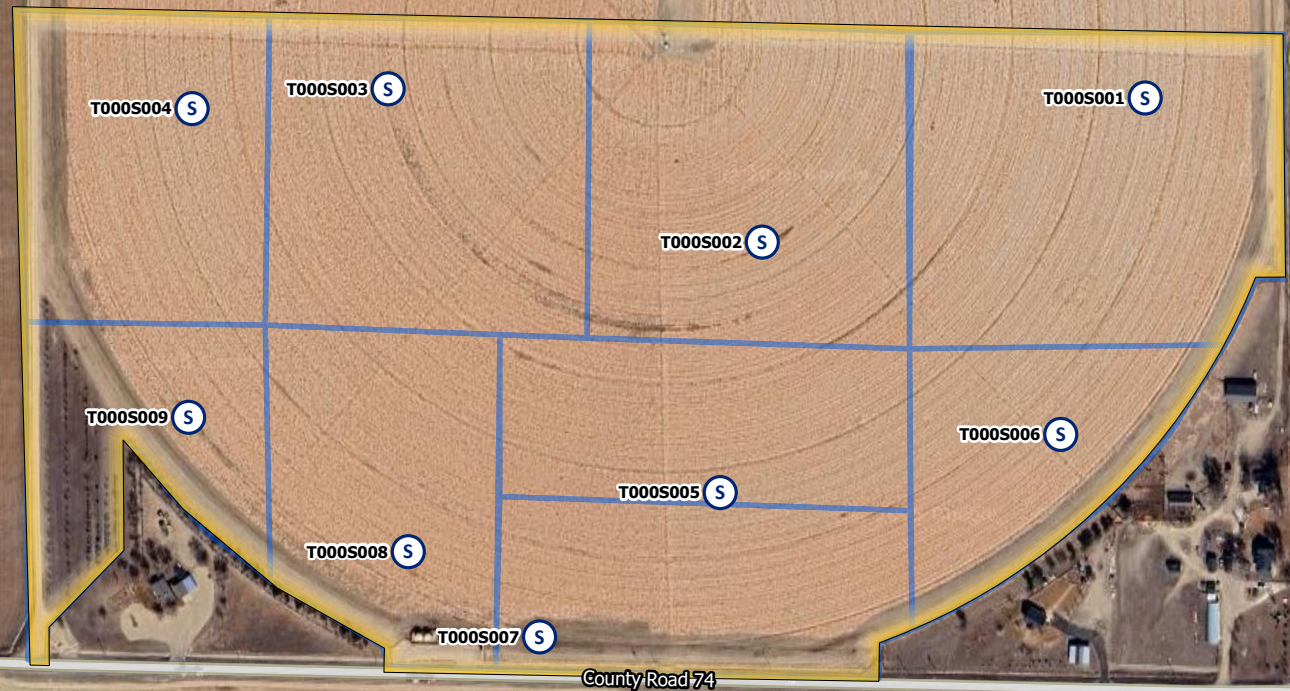

County Road 49

County Road 74

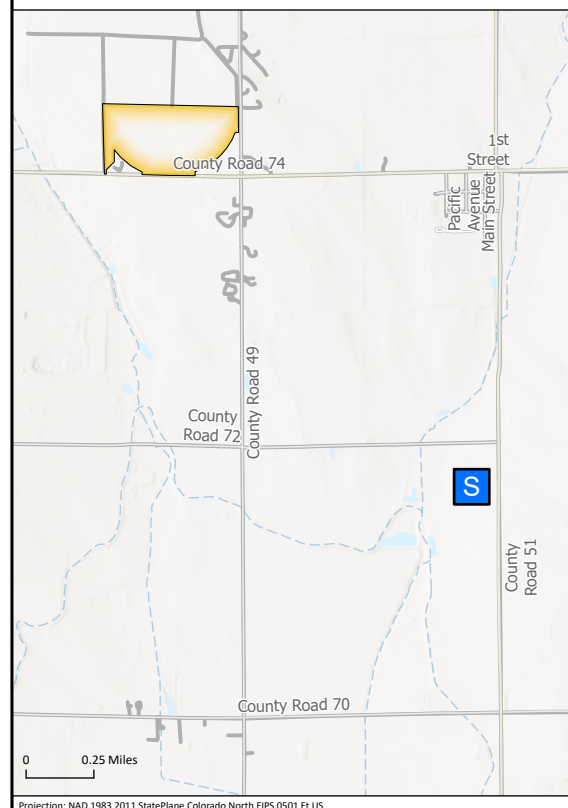

0 100 200 Feet