


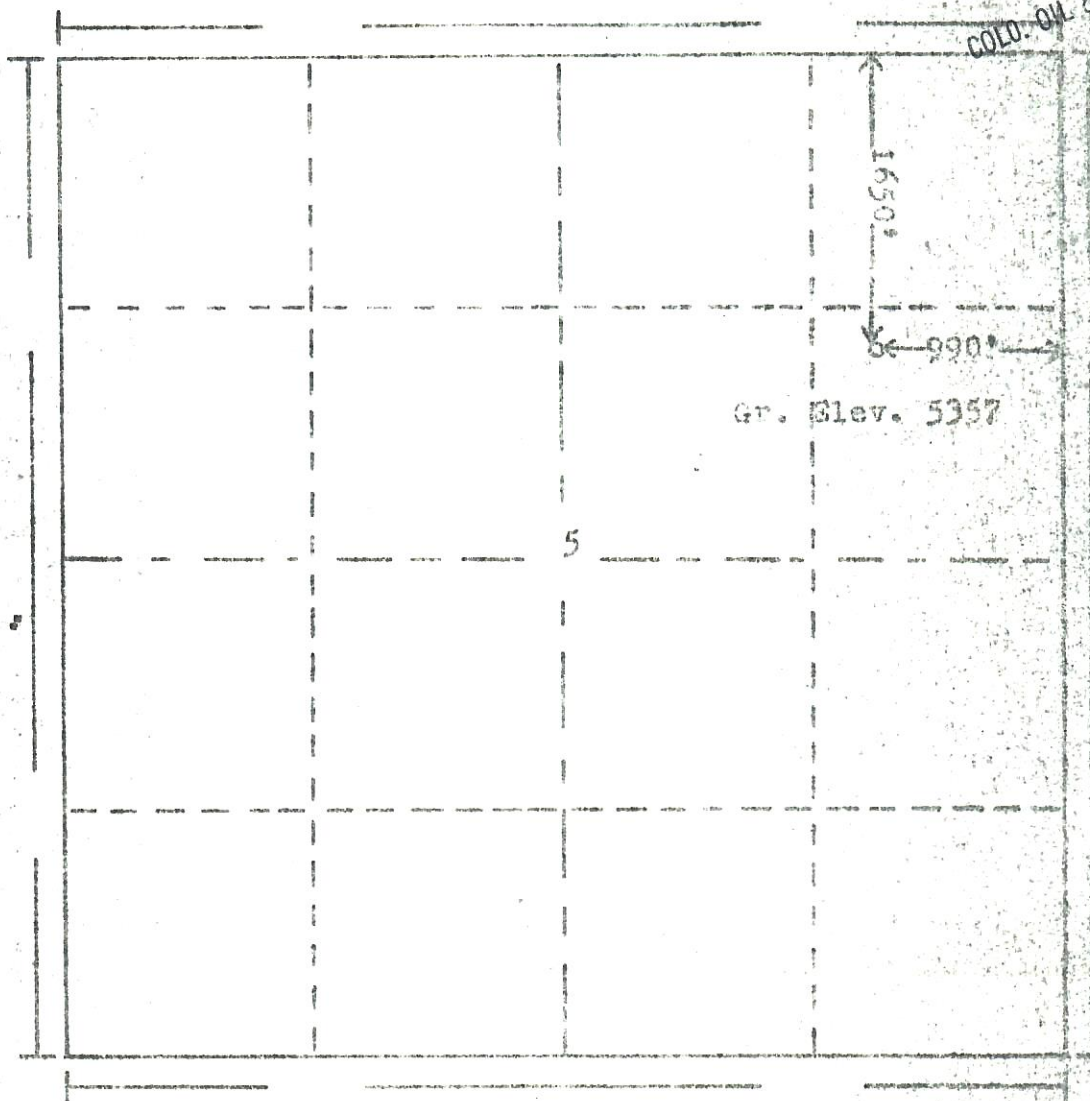

01082962

R. 64W

RECEIVED
JUL 14 1980
COLD OIL & GAS CONS. COMM.

Scale... 1" = 1000'

Powers Elevation of Denver, Colorado
has in accordance with a request from Mr. Hoffer
for Sohio Petroleum Co.
determined the location of No. 5-8 Qualls
to be C NW SE NE Section 5 Township 25
Range 64W of the 6th Principal Meridian
Adams County, Colorado

I hereby certify that this plot is an
accurate representation of a correct
survey showing the location of

Date: 6-16-80

Richard H. Hoffer
Licensed Land Surveyor No. 2852
State of Colorado

5

ROUTING SLIP

DVR	<input type="checkbox"/>
FJP	<input checked="" type="checkbox"/>
HIIM	<input checked="" type="checkbox"/>
JAM	<input checked="" type="checkbox"/>
JJD	<input checked="" type="checkbox"/>
RLS	<input checked="" type="checkbox"/>
CGM	<input checked="" type="checkbox"/>

1/18/78

Date Permit Received

07/14/80

PERMIT NO. 80-879

BOND Blanket

Date of Check 07/10/80

Check # 02302 Amt. \$ 75.00

Name of Company Sohio Petroleum Co

Maker of Check Same

Bank Check Issued On Wgo National Bank

Refund \$ 0.00 Requested By Wgo

Date Refund Request Sent to Accounting

Remarks