



FORM F-100



00405450

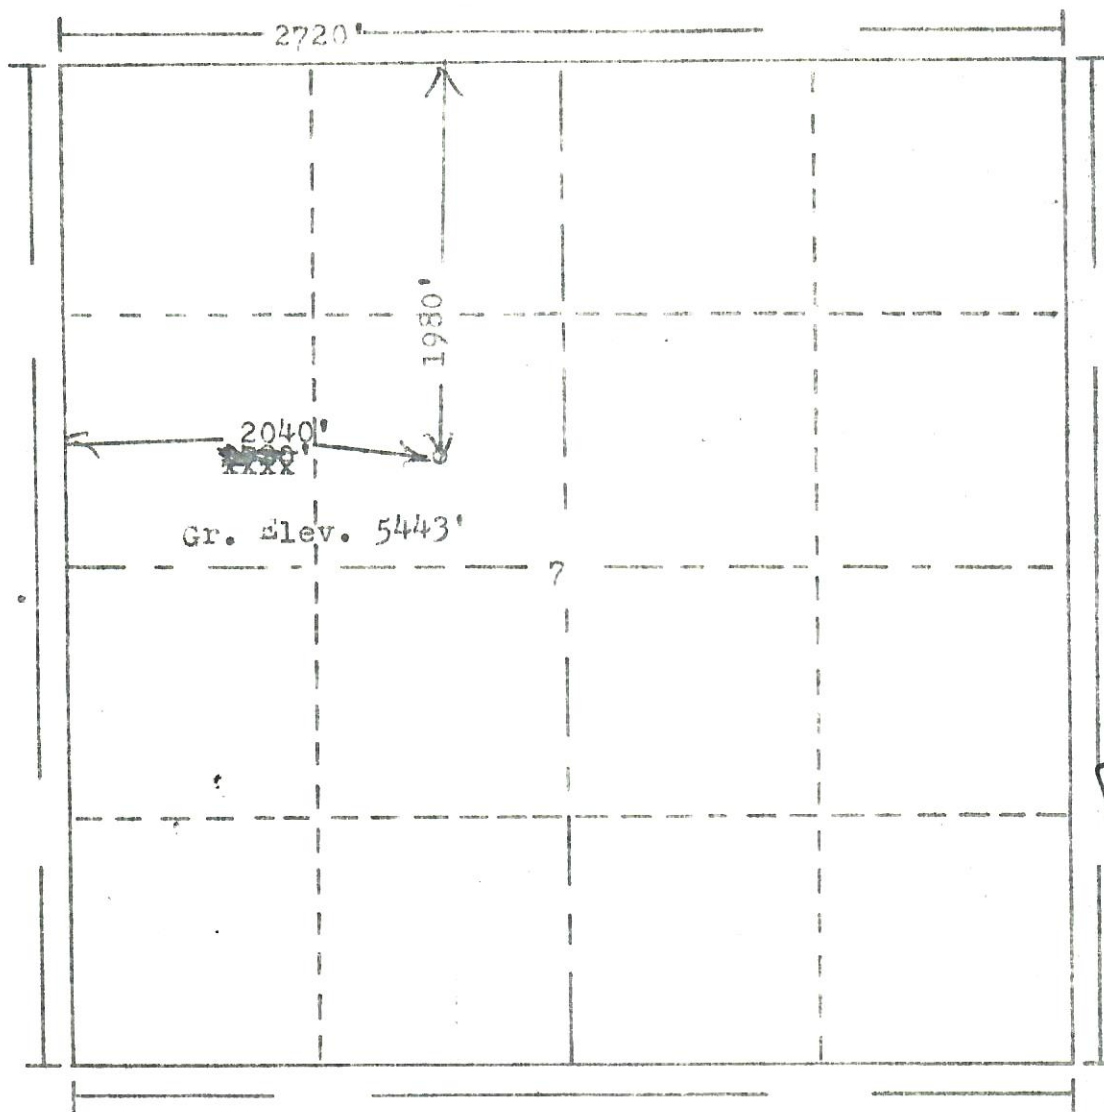
80-1026

RECEIVED

AUG 27 1980

COLO. OIL &amp; GAS CONS. COMM.

R. 64W

BEST COPY  
AVAILABLET.  
3  
S

DVR	
FJP	
HHM	
JAM	
JJD	
RLS	
OSM	

Scale... 1" = 1000'

Powers Elevation Company, Inc. of Denver, Colorado  
has in accordance with a request from Mr. Ward  
for Sohio Petroleum Co.  
determined the location of No. 7-6 UPRR-Amoco  
to be CSE NW Section 7 Township 3S  
Range 64W of the 6th Principal Meridian  
Adams County, Colorado

I hereby certify that this plat is an  
accurate representation of a correct  
survey showing the location of

Date: 8-19-80

*Barry J. Hannon*  
\_\_\_\_\_  
Licensed Land Surveyor No. 2853  
State of Colorado