



FORM E-106

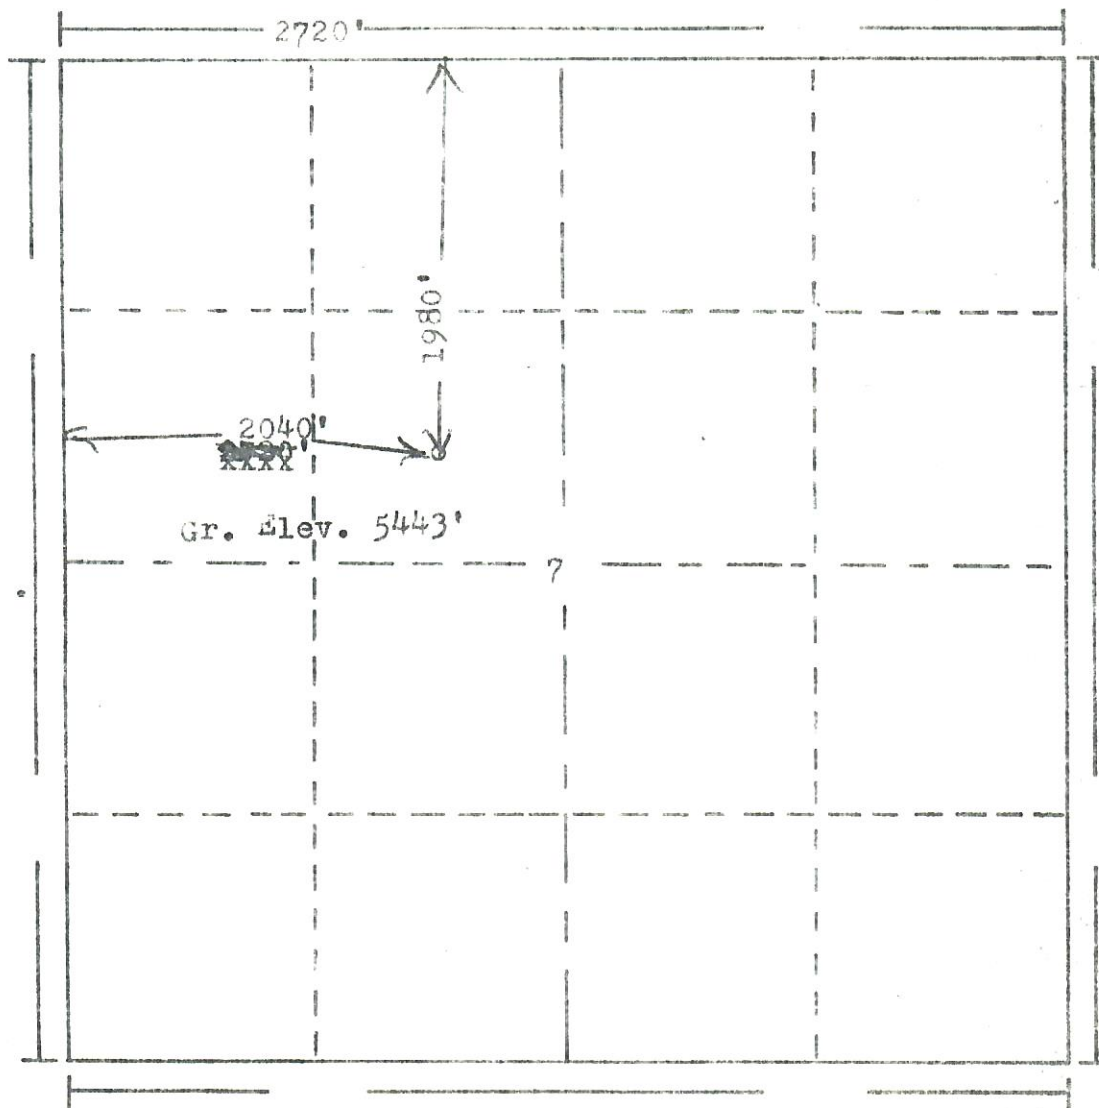


00405454

RECEIVED

AUG 27 1980

R. 64W COLO. OIL &amp; GAS CONS. COMM.

T.  
3  
S

Scale... 1" = 1000'

Powers Elevation Company, Inc. of Denver, Colorado  
has in accordance with a request from Mr. Ward  
for Sohio Petroleum Co.

determined the location of No. 7-6 UPRR-Amoco  
to be CSE NW Section 7 Township 3S  
Range 64W of the 6th Principal Meridian  
Adams County, Colorado

I hereby certify that this plat is an  
accurate representation of a correct  
survey showing the location of

Date: 8-19-80

*Ben J. Hannon*  
Licensed Land Surveyor No. 2853  
State of Colorado