

*State
Oil & Gas Comm*

ROCHESTER & GOODELL
ENGINEERS, INC.
STERLING, COLORADO



British American
Naggatz # C1

304-8

LOCATION OF WELL

330 ft. north; or _____ ft. south; and 990 ft. east; or _____ ft. west of the SW corner


of the _____ Quarter of the _____ Quarter of the _____ Quarter of Section 10, Township 8N

Range 54W of the 6th Principal Meridian, Logan County, Colo.

Elevation—Ground _____ D. Floor _____

RECEIVED
APR 20 1953

OIL & GAS
CONSERVATION COMMISSION

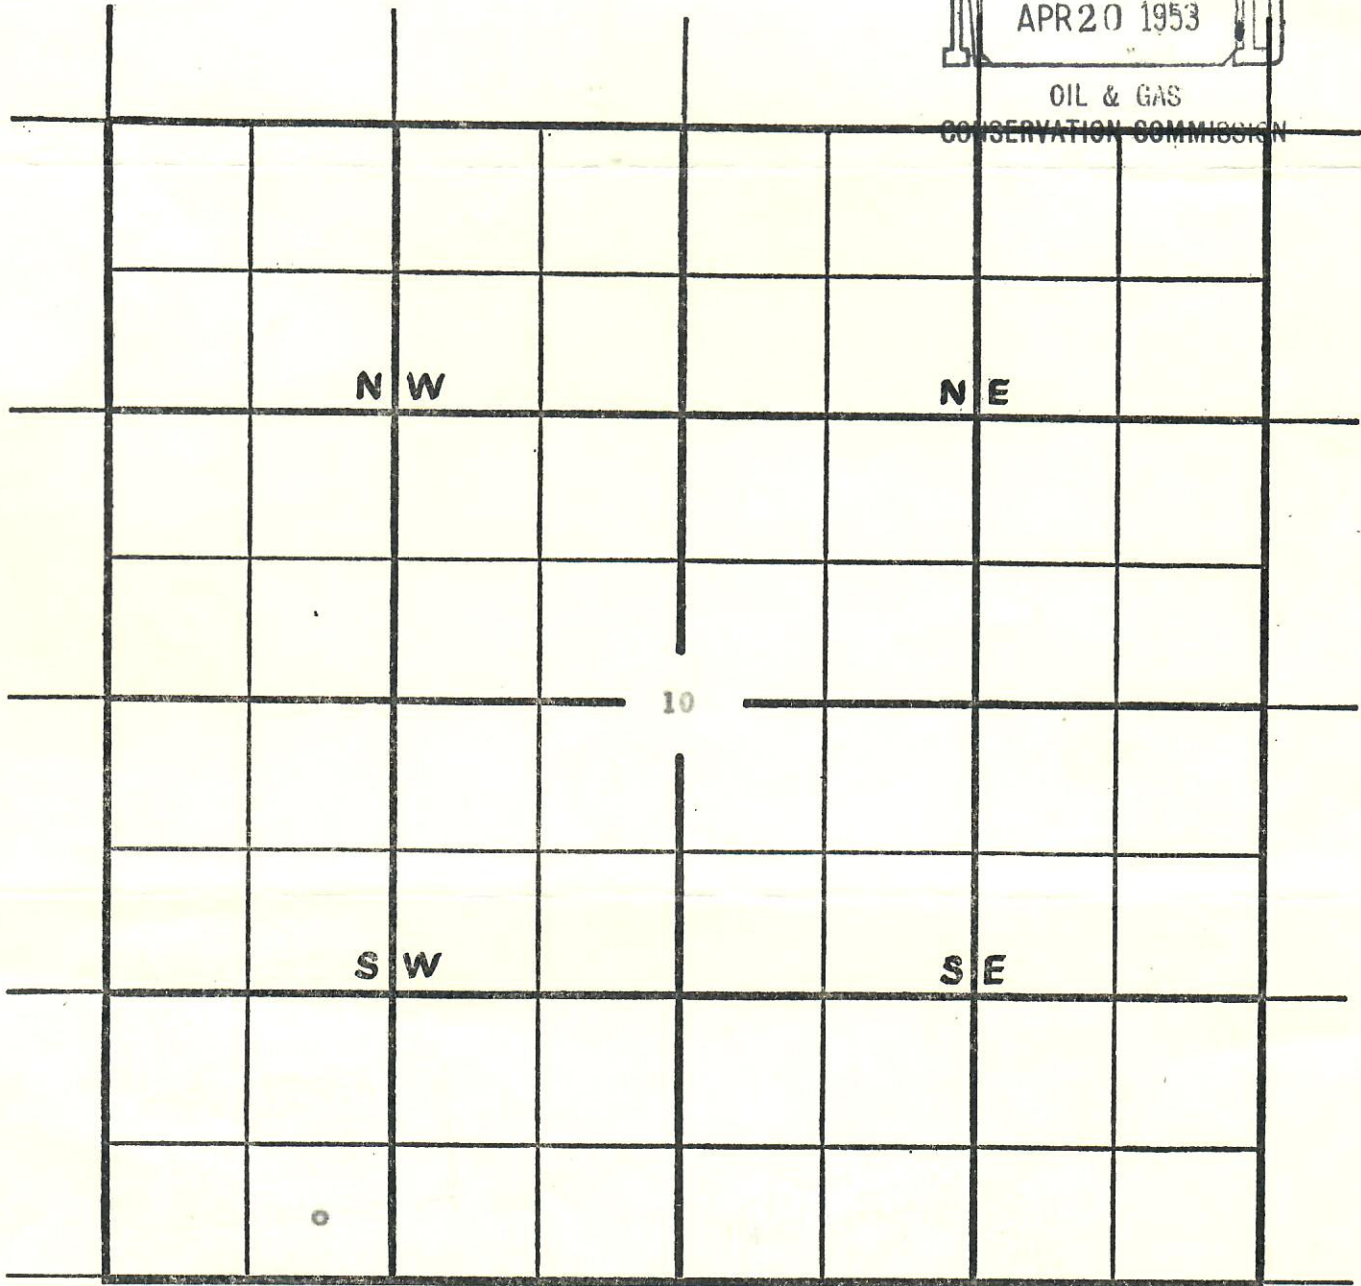

Scale—6" equals 1 mile; smallest squares are 660' x 660', and contains 10 acres.

Frank M. Roberts
Registered Colorado Land Surveyor

ROCHESTER & GOODELL
ENGINEERS, INC.